
## OneBeacon | FLOOR 11 29,461 RSF

As Built

Fully furnished - Available NOW

CLICK HERE TO TOUR THE 11TH FLOOR

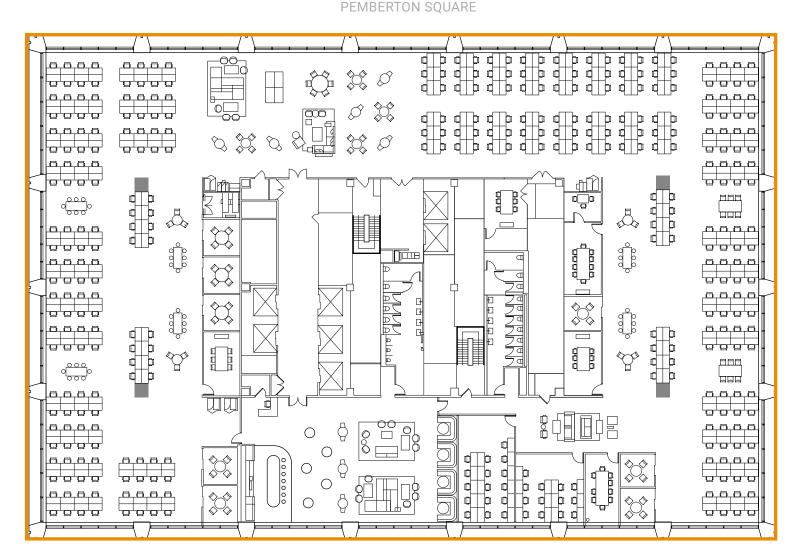

SOMERSET STREET

TREMONT STREET

Ń

BEACON STREET

