
OneBeacon FLOOR 17 2,952 RSF

As Built

PEMBERTON SQUARE

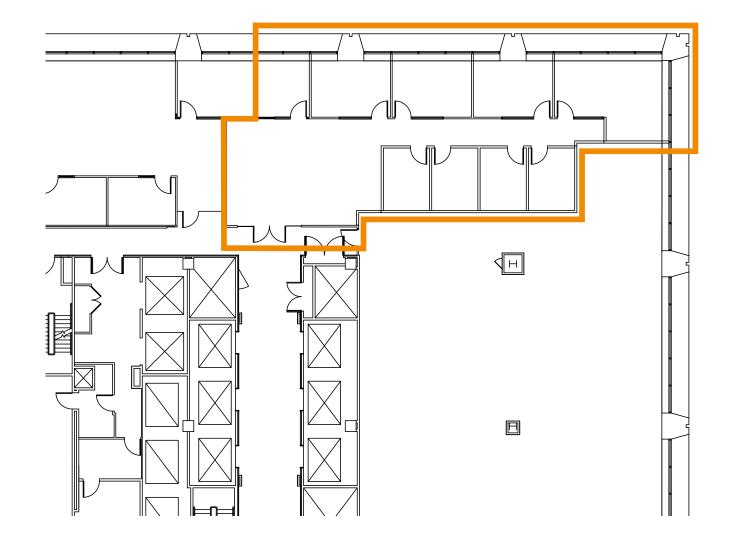

BEACON STREET

SOMERSET STREET

N

