


Mezzanine Level
 1/8" = 1'-0"

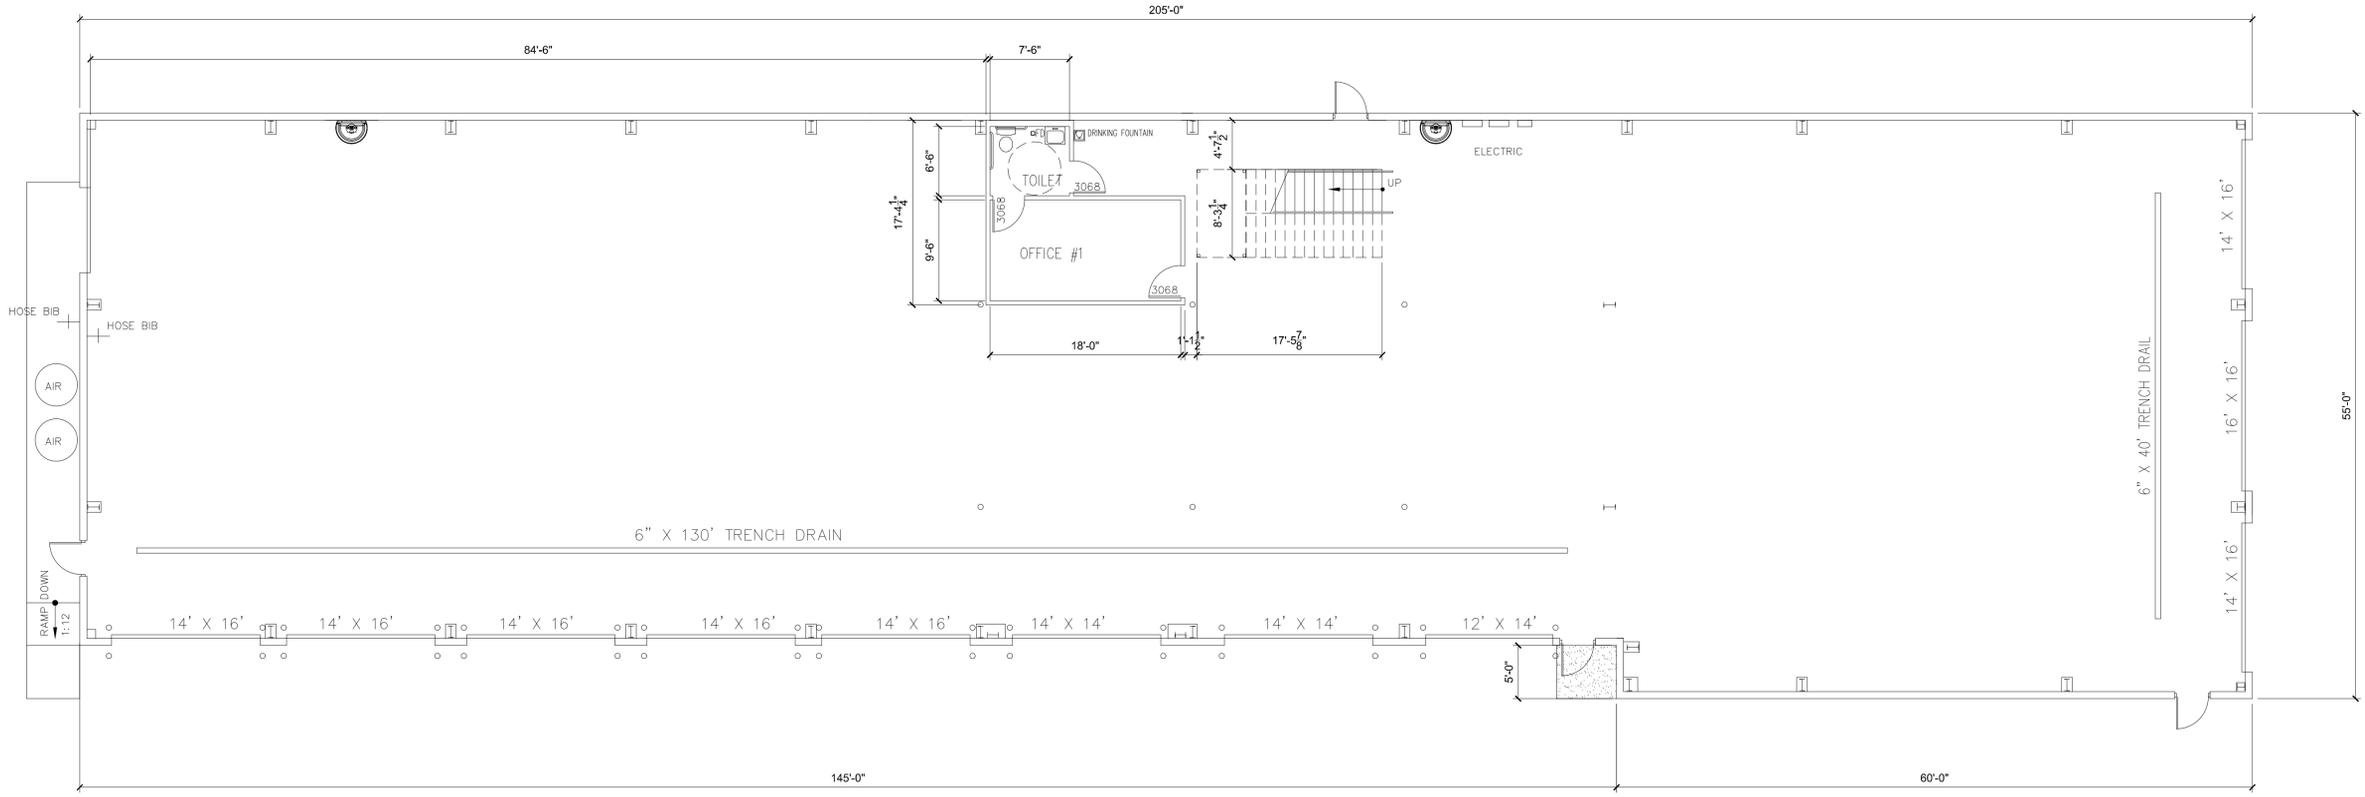

Main Level
 1/8" = 1'-0"

NOTE:
 AS BUILT CONDITIONS SHOWN ARE BASED ON EXISTING DRAWINGS PROVIDED. ALL CONDITIONS MUST BE VERIFIED IN THE FIELD PRIOR TO ANY CONSTRUCTION. ANY CONFLICT BETWEEN THESE PLANS AND THE ACTUAL FIELD CONDITIONS SHALL BE REPORTED IMMEDIATELY TO THE ARCHITECT FOR VERIFICATION AND/OR CORRECTION.

Existing Plans for
**Hoffmann
 Brothers
 Truck
 Maintenance
 Building**

3700 Rider Trail
 Earth City, MO

2-5-26 For Site Verification

Floor Plans
EX1

Hoffmann Brothers
 3700 Rider Trail
 2025.139