


AS BUILT FLOOR 4 PLAN

5965 E. Broad St | Columbus, OH 43213

07/12/2021

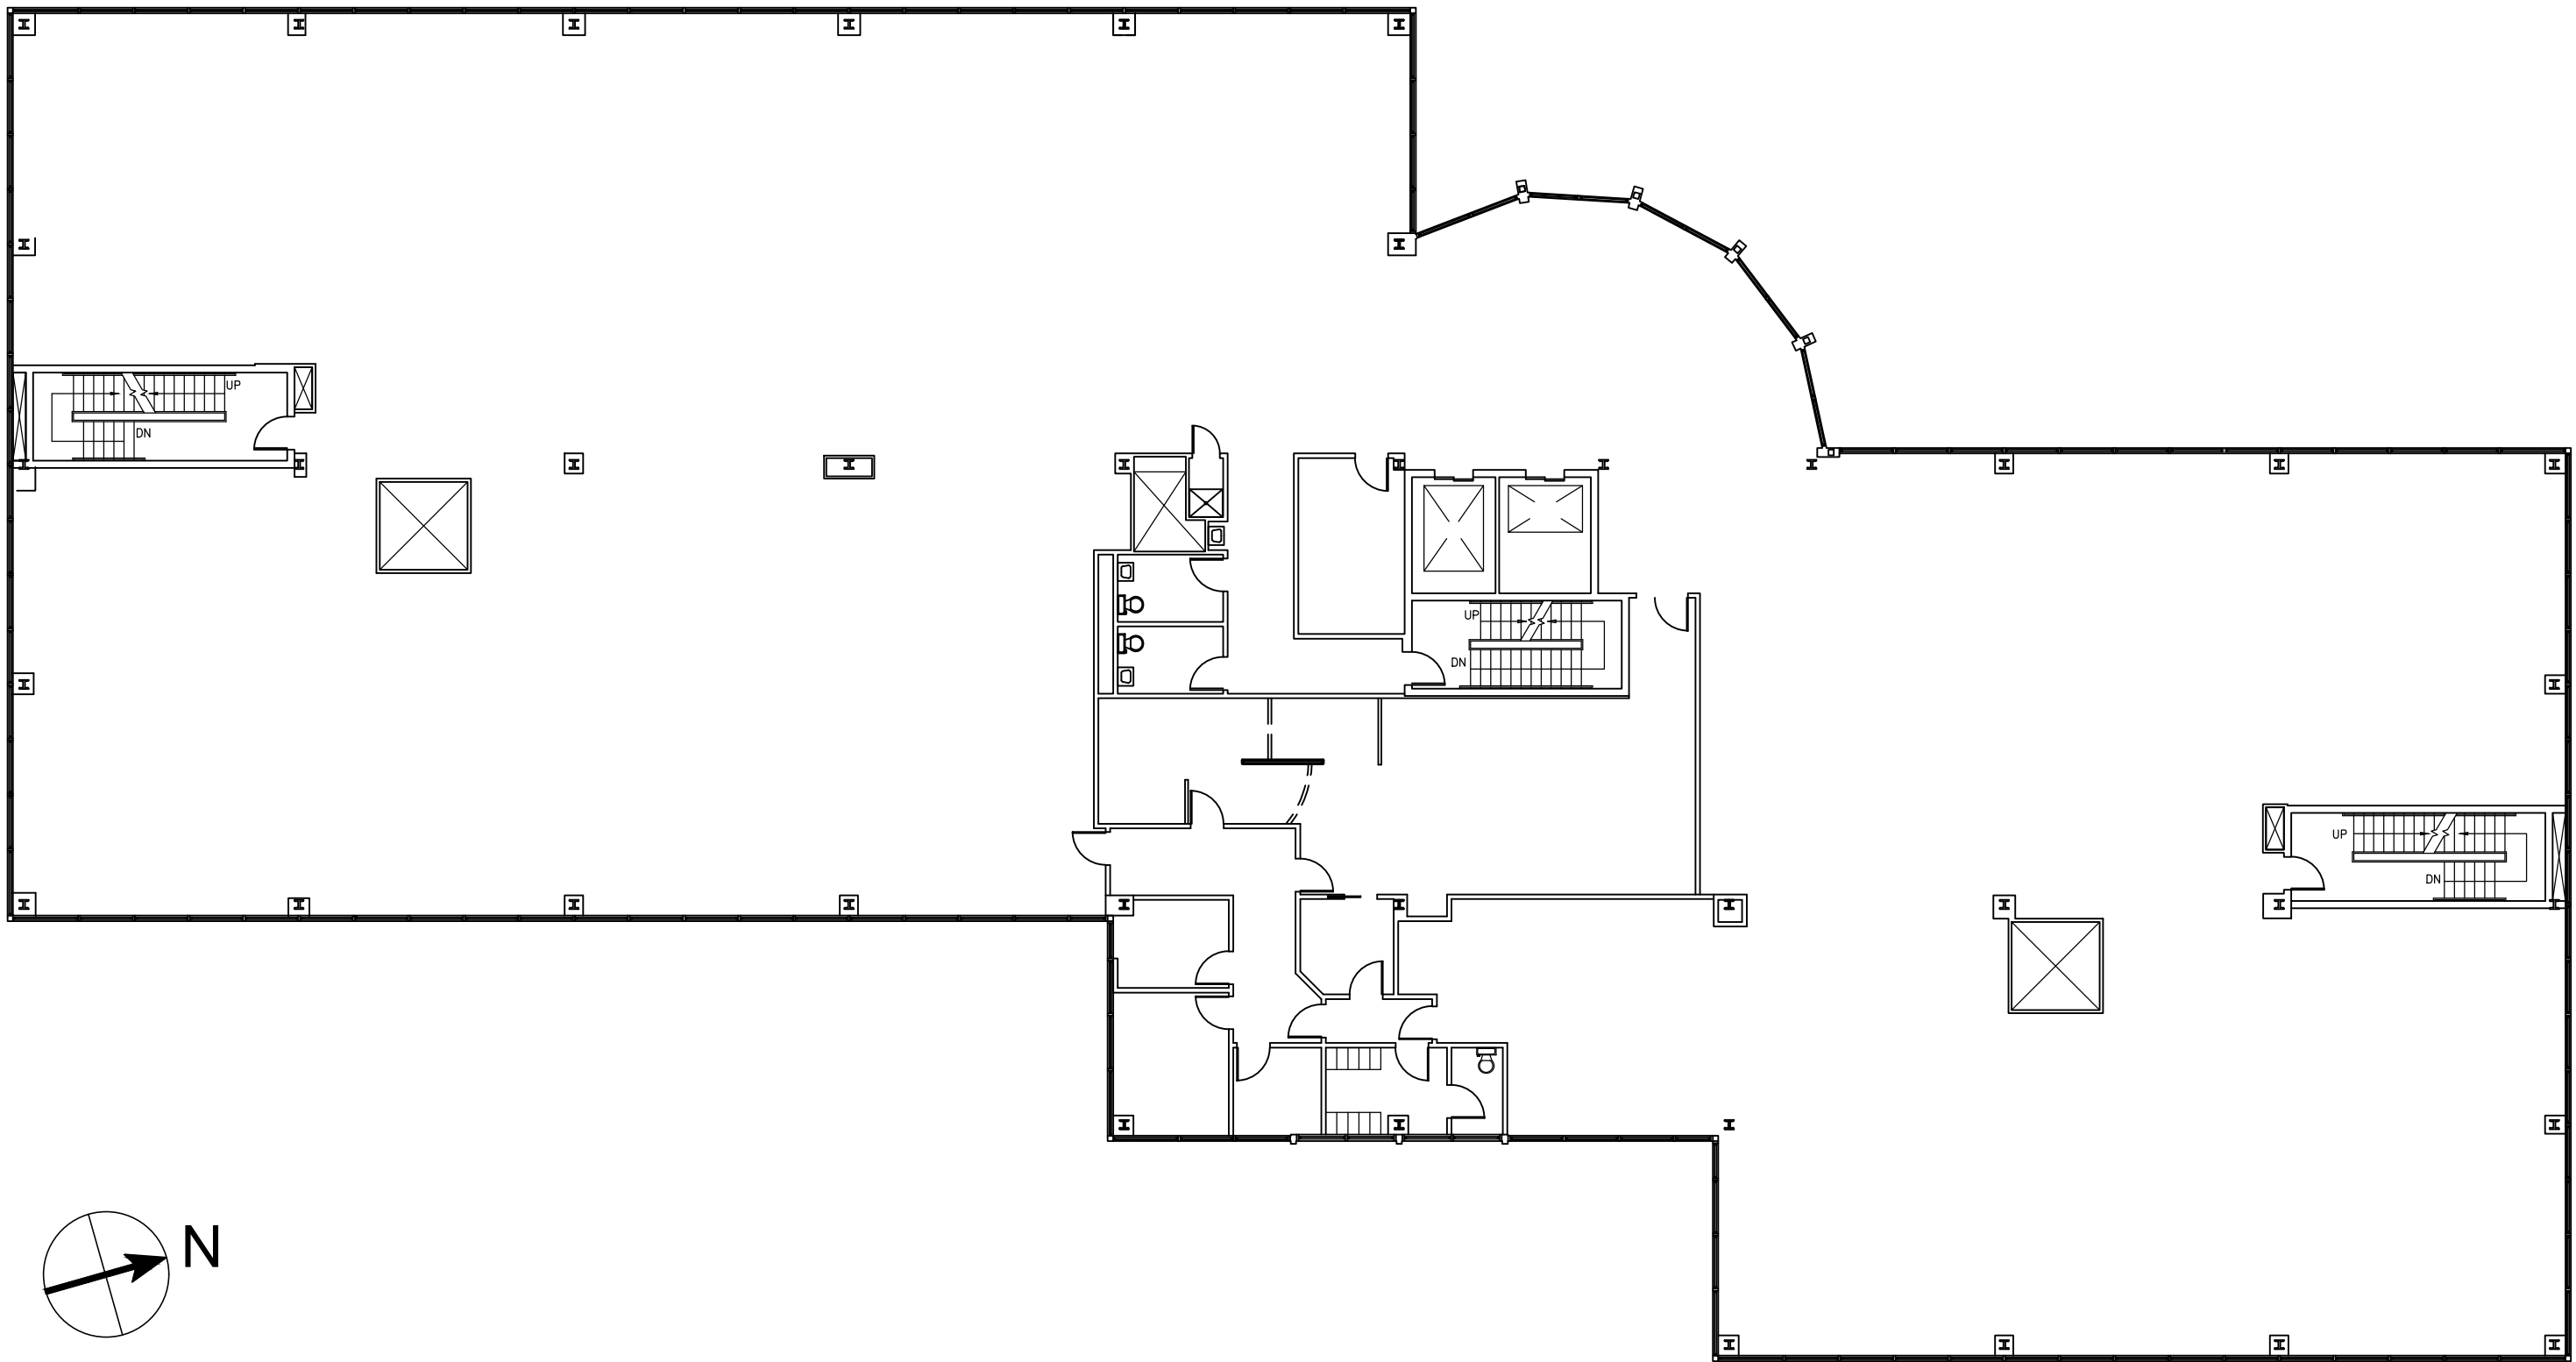