



5,479 s.f.

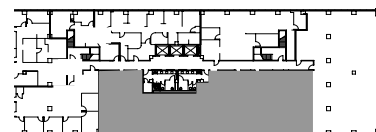

TAKE A TOUR

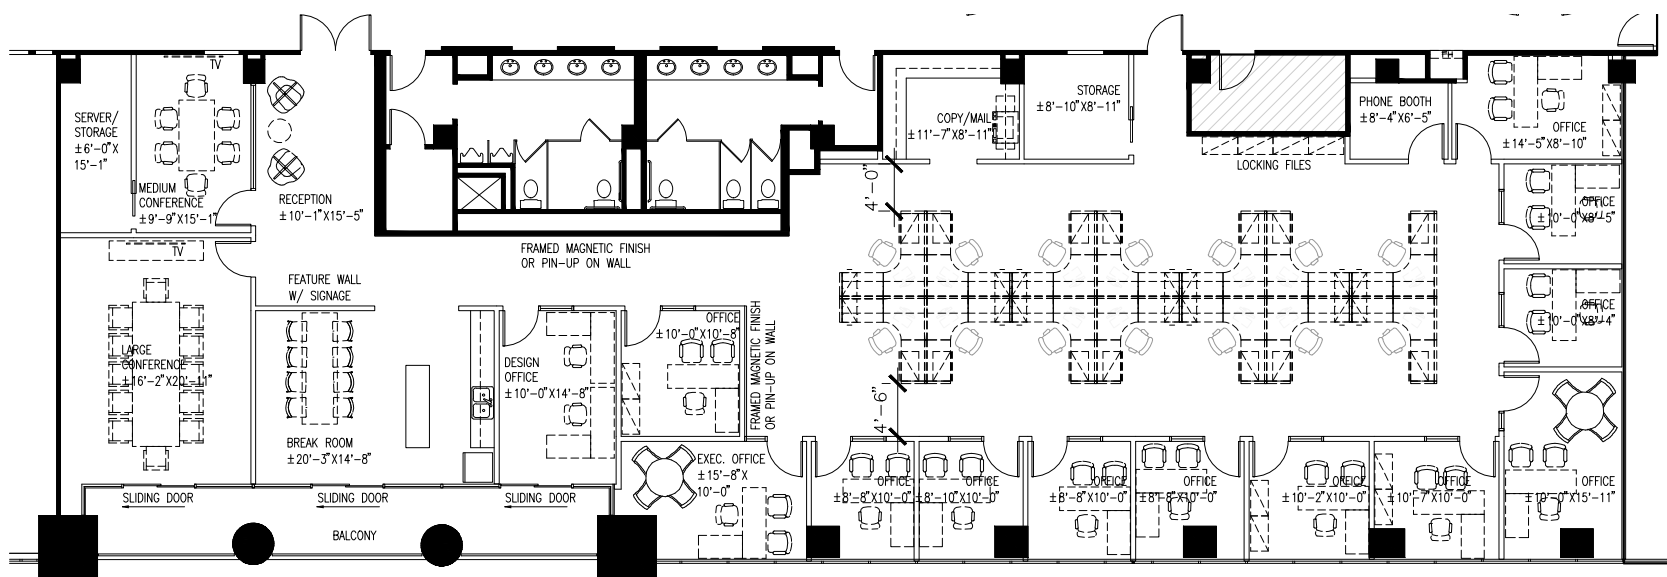

Leading contacts:
Bess Wakeman
+1 858 410 1245
bess.wakeman@jll.com
RE license #01177659



Tim Olson
+1 858 410 1253
tim.olson@jll.com
RE License #01364117

www.1450frazee.com

SUITE 205

2,623 s.f.

▶ TAKE A TOUR

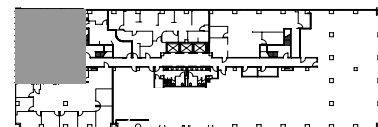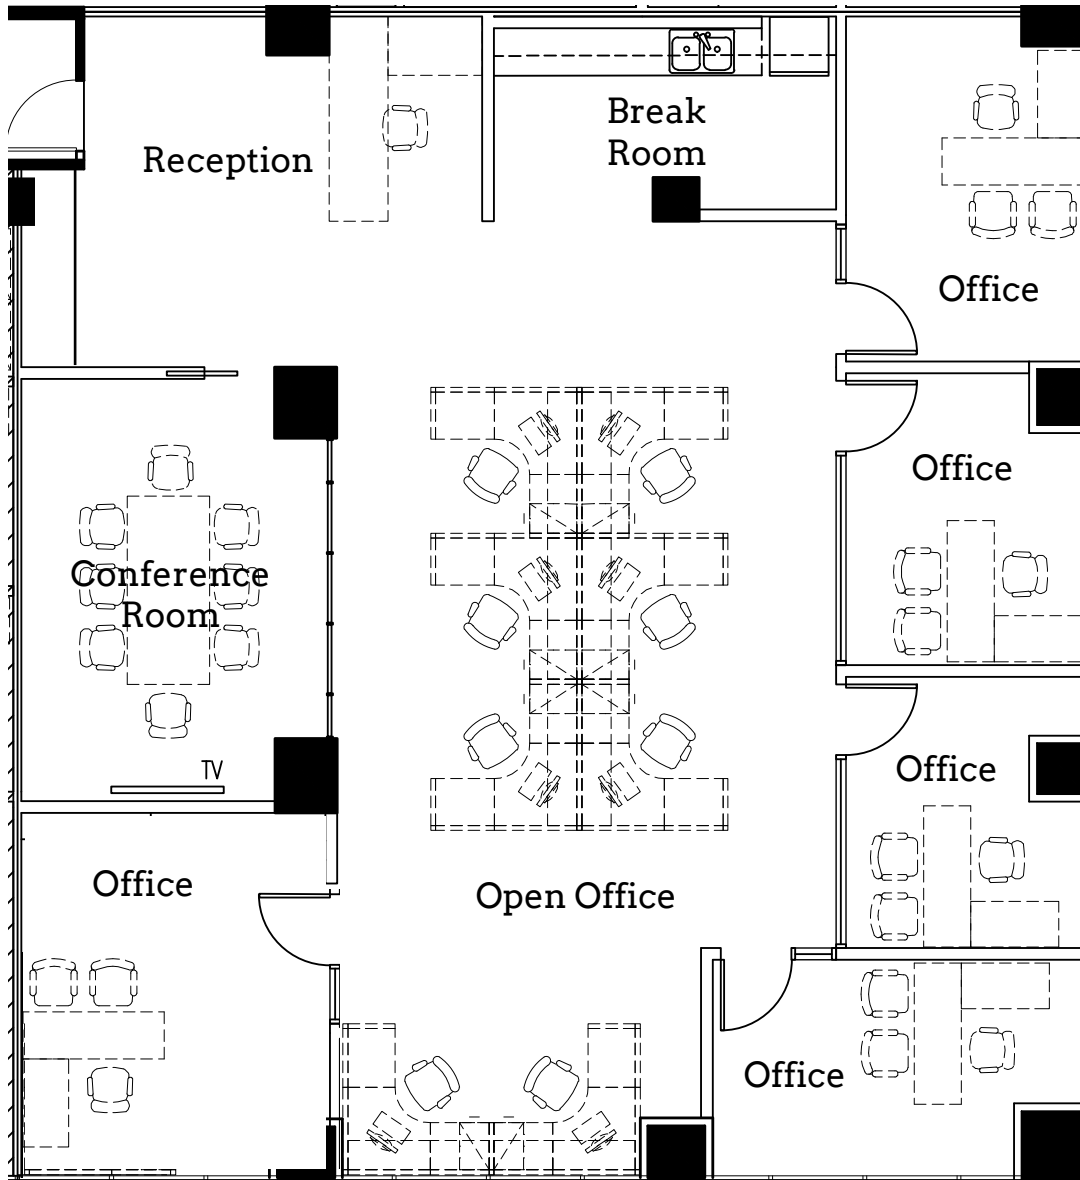

Leasing contacts:

Bess Wakeman
+1 858 410 1245
bess.wakeman@jll.com
RE license #01177659



Tim Olson
+1 858 410 1253
tim.olson@jll.com
RE License #01364117

www.1450frazee.com

SUITE 225

2,146 s.f.

 TAKE A TOUR

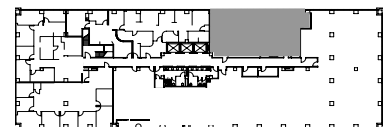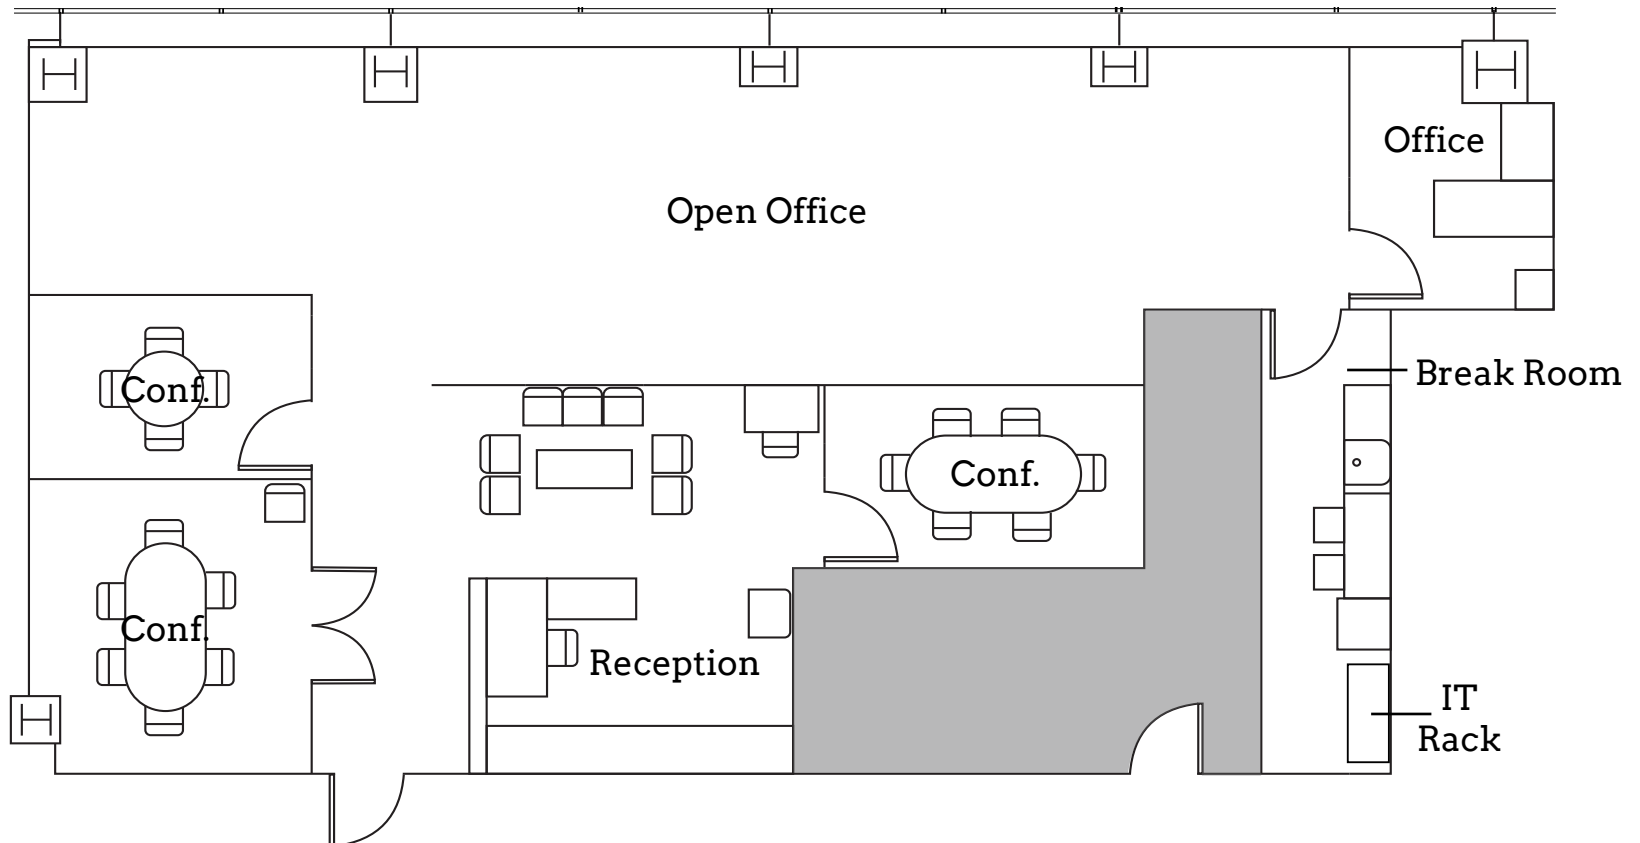

Leasing contacts:
Bess Wakeman
+1 858 410 1245
bess.wakeman@jll.com
RE license #01177659

Tim Olson
+1 858 410 1253
tim.olson@jll.com
RE License #01364117



www.1450frazee.com

SUITE 400

2,718 s.f.



TAKE A TOUR

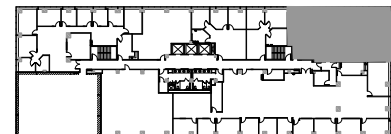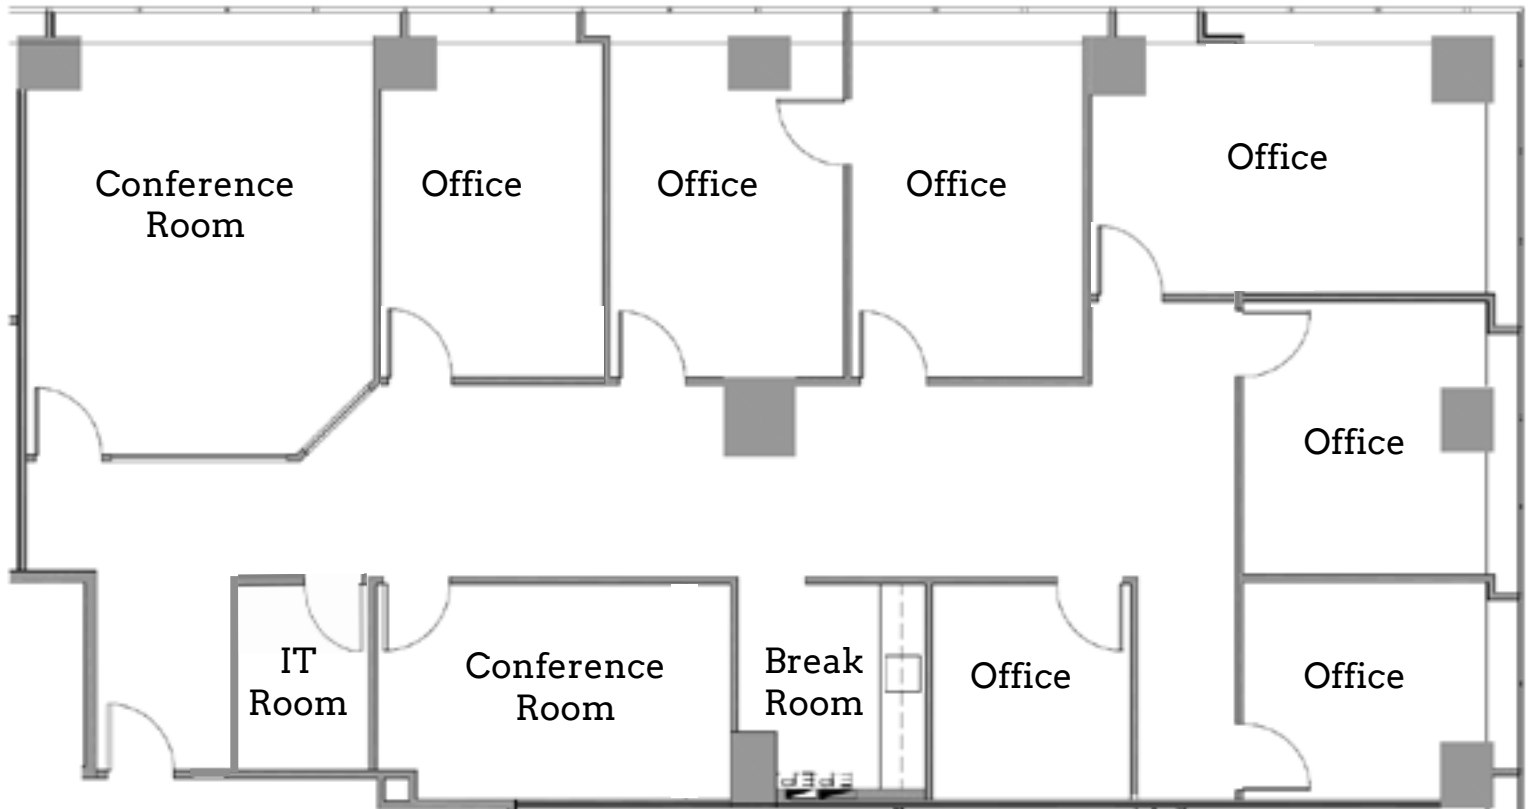

Leasing contacts:

Bess Wakeman
+1 858 410 1245
bess.wakeman@jll.com
RE license #01177659



Tim Olson
+1 858 410 1253
tim.olson@jll.com
RE License #01364117

www.1450frazee.com

SUITE 405

2,179 s.f.

 TAKE A TOUR

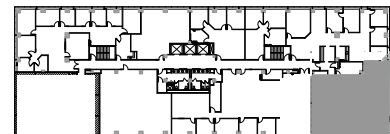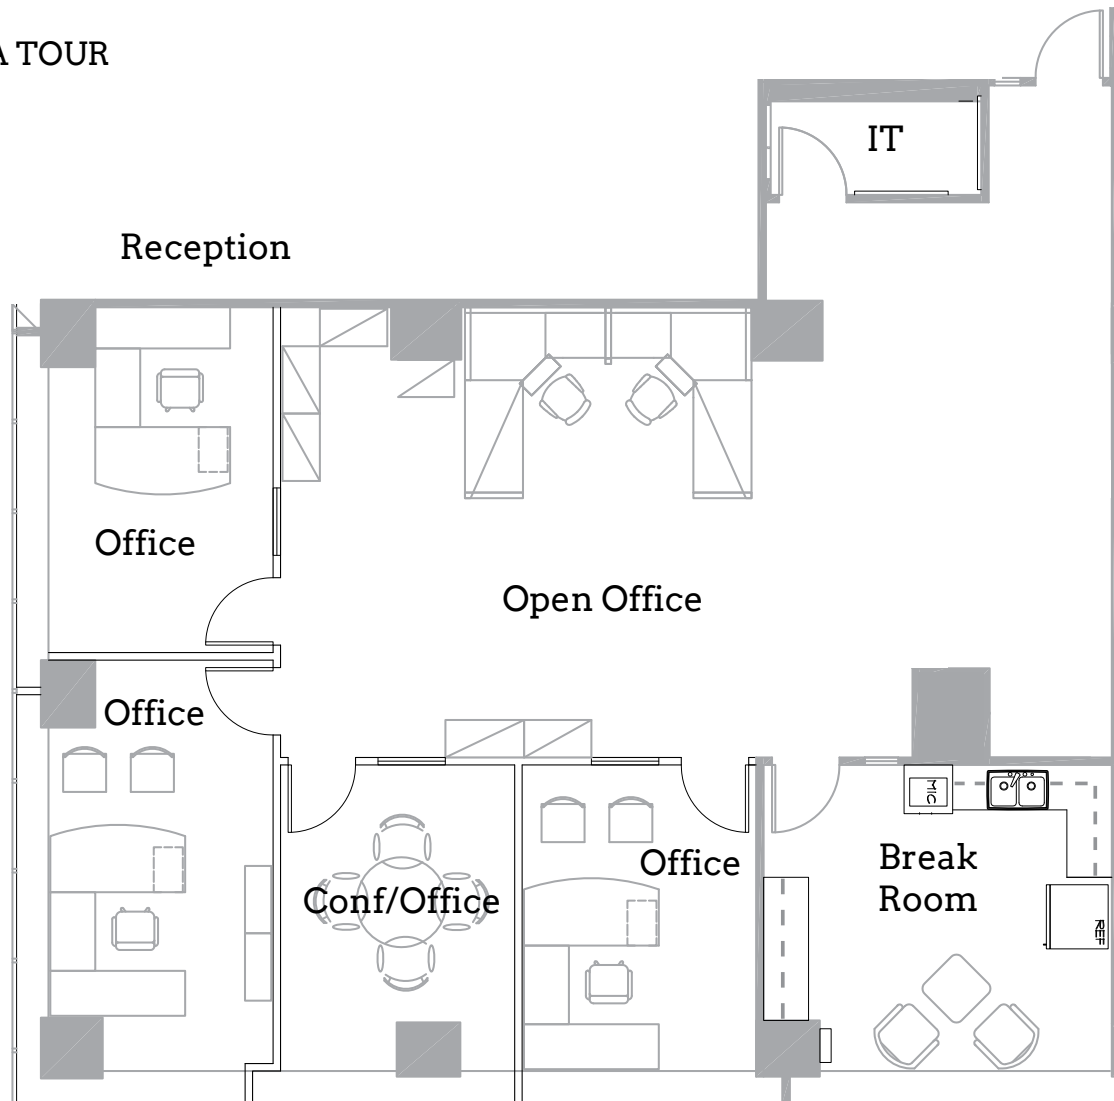

Leasing contacts:
Bess Wakeman
+1 858 410 1245
bess.wakeman@jll.com
RE license #01177659

Tim Olson
+1 858 410 1253
tim.olson@jll.com
RE License #01364117


www.1450frazee.com

SUITE 410

2,356 s.f.



TAKE A TOUR

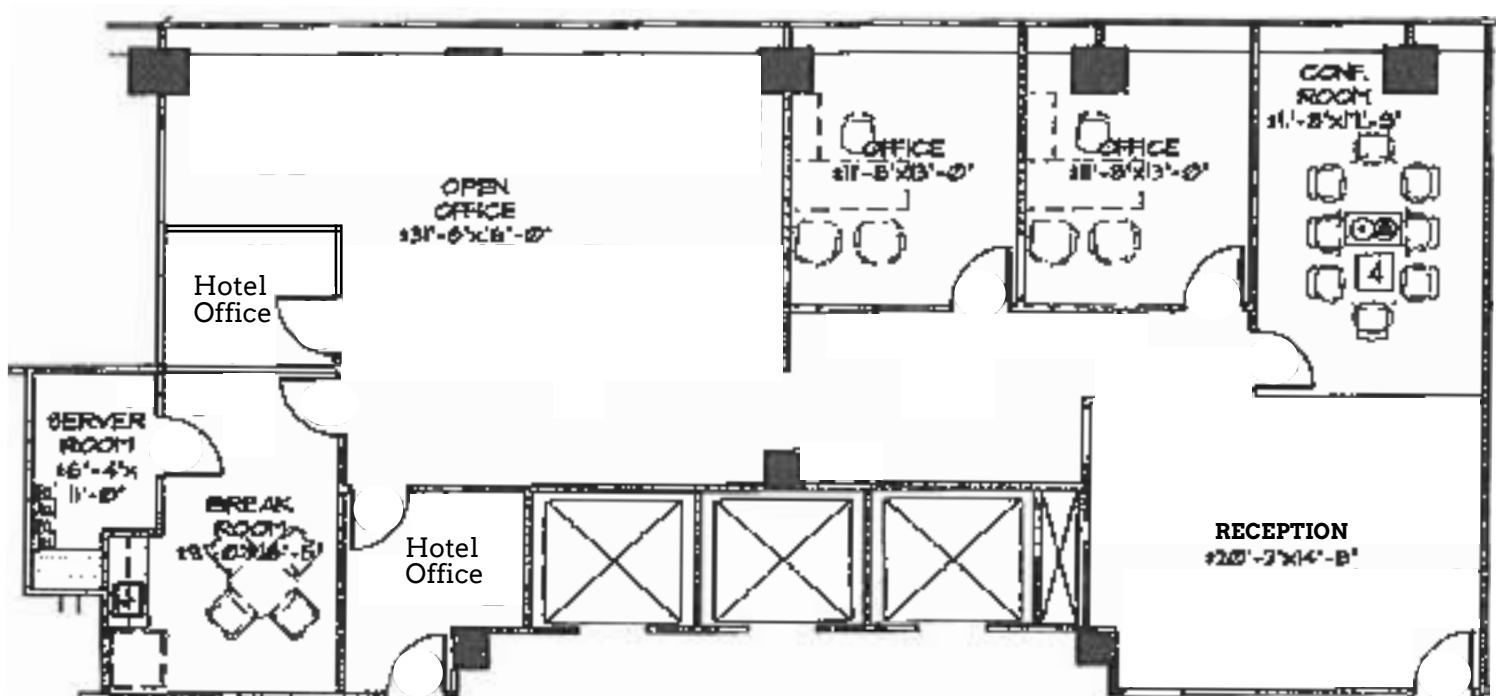

Leasing contacts:


Bess Wakeman
+1 858 410 1245
bess.wakeman@jll.com
RE license #01177659

Tim Olson
+1 858 410 1253
tim.olson@jll.com
RE License #01364117

www.1450frazee.com

SUITE 500

±17,586 s.f.

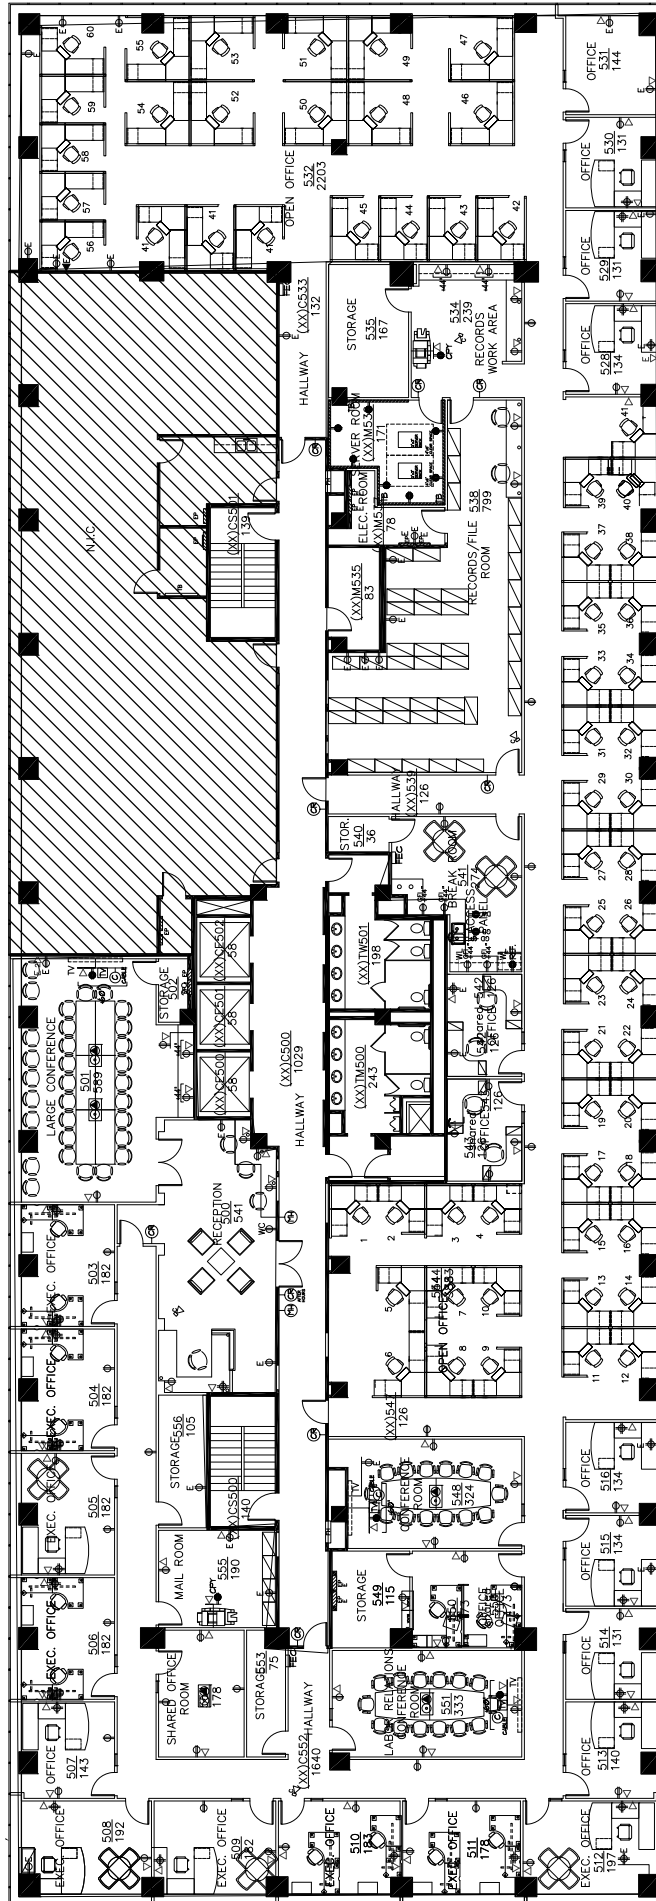

Leasing contacts:
 Bess Wakeman
 +1 858 410 1245
 bess.wakeman@jll.com
 RE license #01177659


Tim Olson
 +1 858 410 1253
 tim.olson@jll.com
 RE License #01364117

www.1450frazee.com

SUITE 700 | AS-BUILT


±13,085 s.f.

[▶ TAKE A TOUR](#)

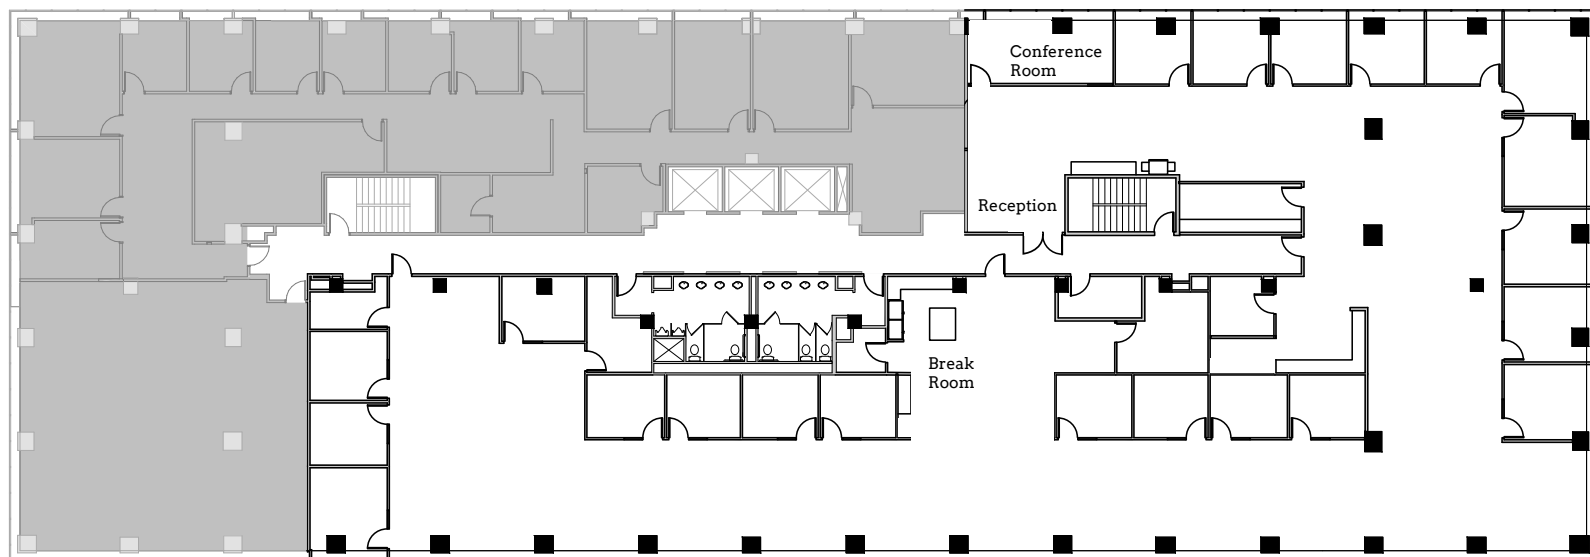


SUITE 700 | DEMISING OPTIONS

OPTION 1: 3 SUITES

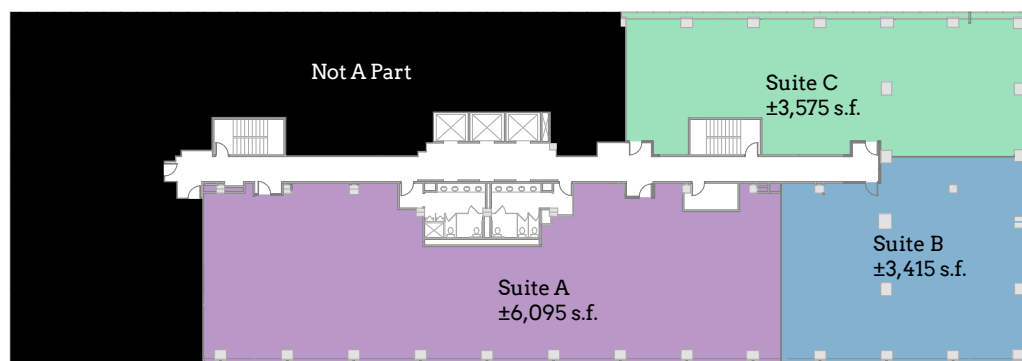

OPTION 2: 2 SUITES

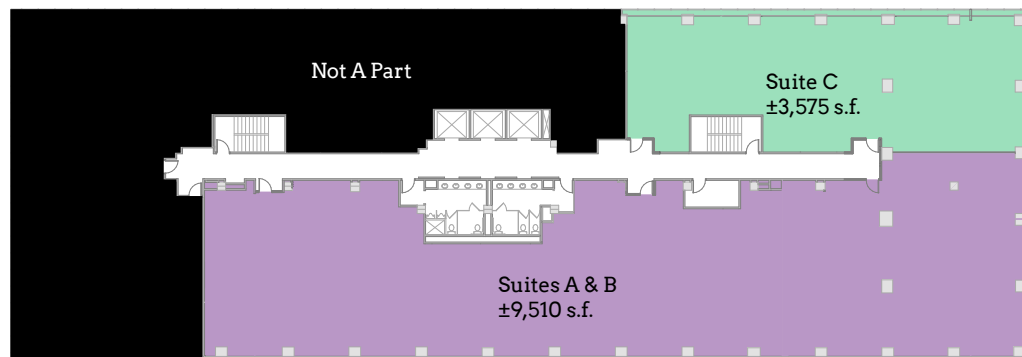

Leasing contacts:

Bess Wakeman
+1 858 410 1245
bess.wakeman@jll.com
RE license #01177659

Tim Olson
+1 858 410 1253
tim.olson@jll.com
RE License #01364117

www.1450frazee.com