

HYUNDA
TRANSLAD



RIO VISTA TOWER

Where Anything is Possible

8880 Rio San Diego Drive
San Diego, CA 92108



www.riovistaoffice.com

Tomorrow's Workspace

Today's Innovation

It's a new era for Rio Vista Tower. Connected, flexible and people-focused. Significant renovations are enhancing its position as a premier Class A office destination in Mission Valley. Offering a range of office spaces, Rio Vista Tower redefines the skyline and drives your business forward.



RIO VISTA
TOWER

Where Anything is Possible



Rio Vista Tower Offers:

WELL CONNECTED

Located near the 5,8,805 and 163 freeways, with the San Diego Trolley just minutes away, commuters have access to convenient transportation options.



ECO-INTELLIGENT DESIGN

Our Energy Star label, solar-covered parking and EV charging stations are our commitment to sustainable innovation.



ADAPTIVE SPACES

Flexible suite layouts empower your business to evolve and thrive as needed.



PEOPLE-FOCUSED AMENITIES

On-site dining, new state-of-the-art fitness center, a new conference center & lounge, under construction

Synergy of Innovation and Functionality



RIO VISTA
TOWER

Where Anything is Possible

Connect and Ignite Ideas



Conference Center

**Under construction*



RIO VISTA
TOWER

Where Anything is Possible

Your Hub for Ideas



Collaborate and Innovate

**Under construction*



Recharge and Renew



New State-of-the-Art
Fitness Center



Where Anything is Possible


8880 Rio San Diego Drive
San Diego, CA 92108

www.riovistaoffice.com

Space Available

Bess Wakeman
Executive Vice President
bess.wakeman@jll.com
+1 858 410 1245
CA RE License #01177659

Tim Olson
Senior Managing Director
tim.olson@jll.com
+1 858 410 1253
CA RE License #01364117

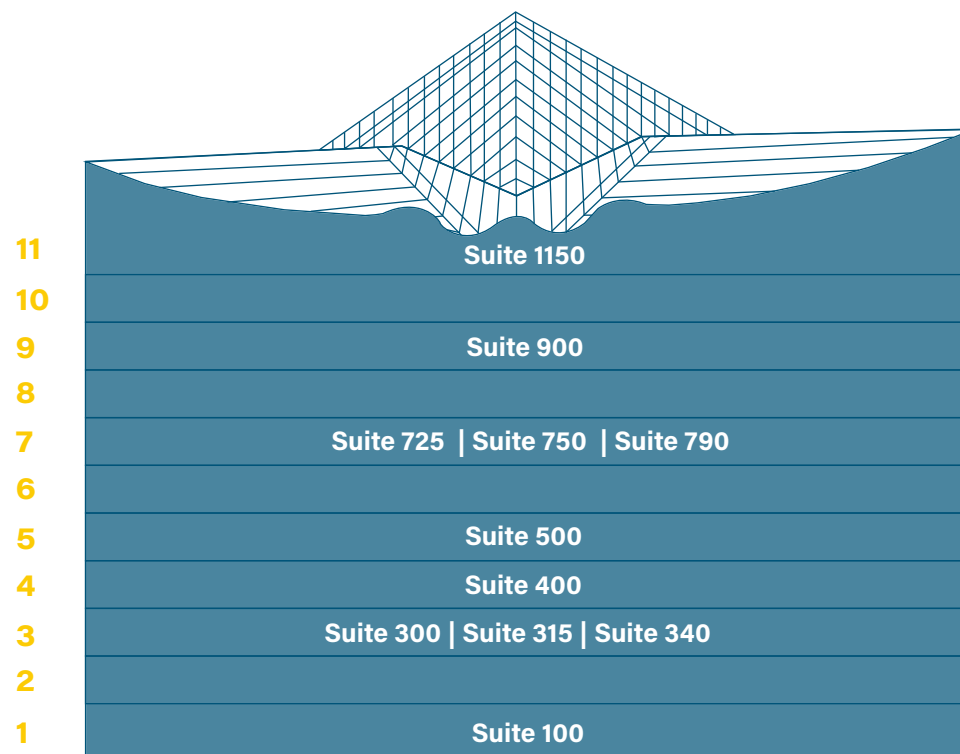

Suite 100 • 7,092 RSF
Available Now

Suite 300 • 2,768 RSF
Available Now

Suite 315 • 2,597 RSF
Available Now

Suite 340 • 2,072 RSF
Available Now

Suite 400 • 18,918 RSF
Available Now

Suite 500 • 17,787 RSF
Available Now

Suite 725 • 2,649 RSF
Available Now

Suite 750* • 5,978 RSF
Available Now

Suite 790* • 2,533 RSF
Available Now

Suite 970 • 2,445 RSF
Available Now

Suite 1150 • 3,471 RSF
Available Now

*Suites 750 & 790 are contiguous for 8,511 RSF



RIO VISTA TOWER

Where Anything is Possible

8880 Rio San Diego Drive
San Diego, CA 92108

www.riovistaoffice.com

Bess Wakeman


Executive Vice President
bess.wakeman@jll.com
+1 858 410 1245
CA RE License #01177659

Tim Olson

Senior Managing Director
tim.olson@jll.com
+1 858 410 1253
CA RE License #01364117

Suite 100 - 7,092 RSF

AS-BUILT PLAN

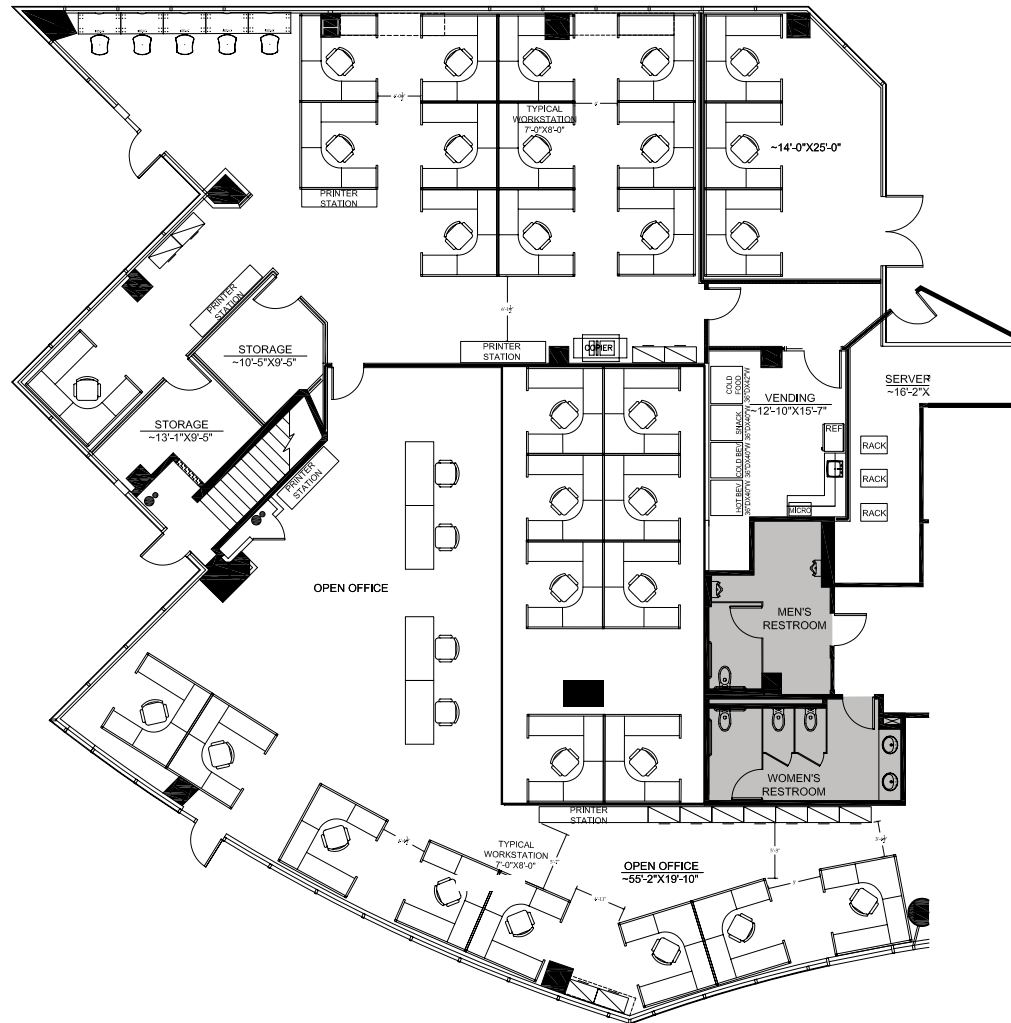



RIO VISTA TOWER

Where Anything is Possible

8880 Rio San Diego Drive
San Diego, CA 92108

www.riovistaoffice.com



Bess Wakeman

Executive Vice President
bess.wakeman@jll.com
+1 858 410 1245
CA RE License #01177659


Tim Olson

Senior Managing Director
tim.olson@jll.com
+1 858 410 1253
CA RE License #01364117

Suite 300 • 2,768 RSF

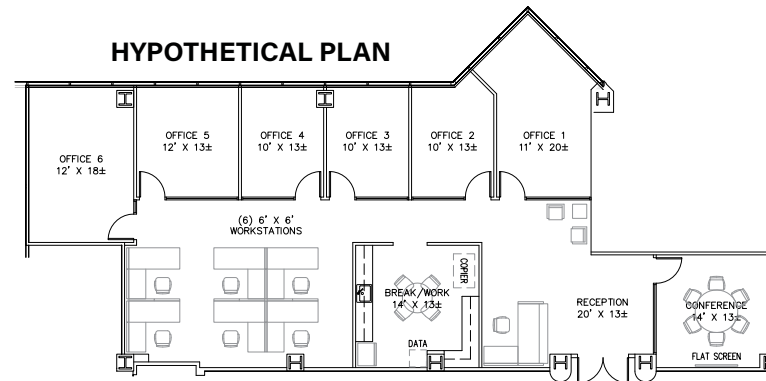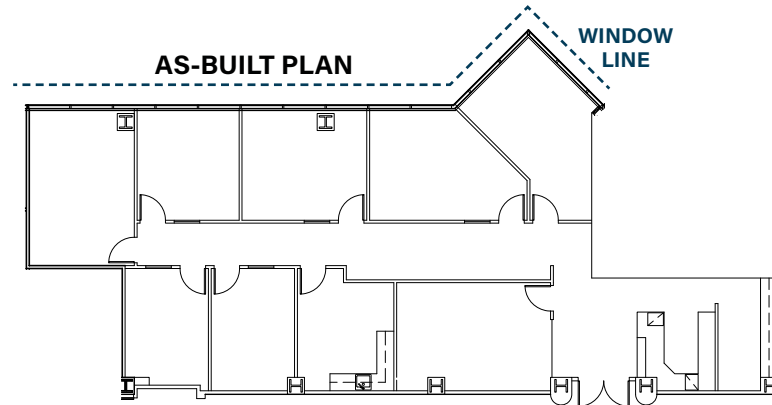

 **Virtual Tour**

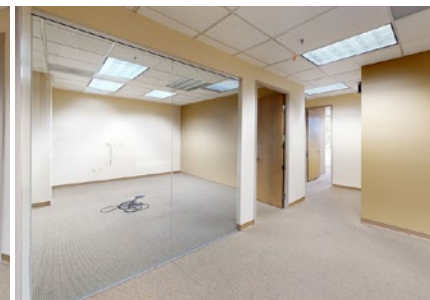



RIO VISTA TOWER

Where Anything is Possible

8880 Rio San Diego Drive
San Diego, CA 92108

www.riovistaoffice.com

Bess Wakeman


Executive Vice President
bess.wakeman@jll.com
+1 858 410 1245
CA RE License #01177659

Tim Olson

Senior Managing Director
tim.olson@jll.com
+1 858 410 1253
CA RE License #01364117

Suite 315 • 2,597 RSF

AS-BUILT PLAN

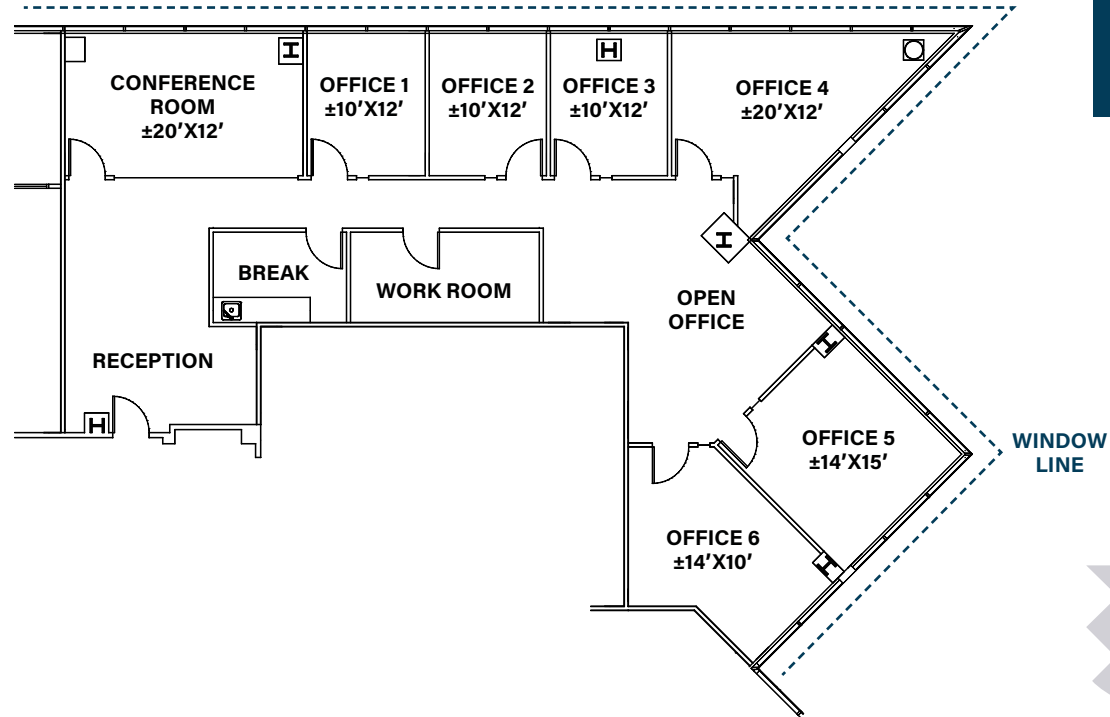

 **Virtual Tour**





RIO VISTA TOWER

Where Anything is Possible

8880 Rio San Diego Drive
San Diego, CA 92108

www.riovistaoffice.com

Bess Wakeman


Executive Vice President
bess.wakeman@jll.com
+1 858 410 1245
CA RE License #01177659

Tim Olson

Senior Managing Director
tim.olson@jll.com
+1 858 410 1253
CA RE License #01364117

Suite 340 • 2,072 RSF

 **Virtual Tour**

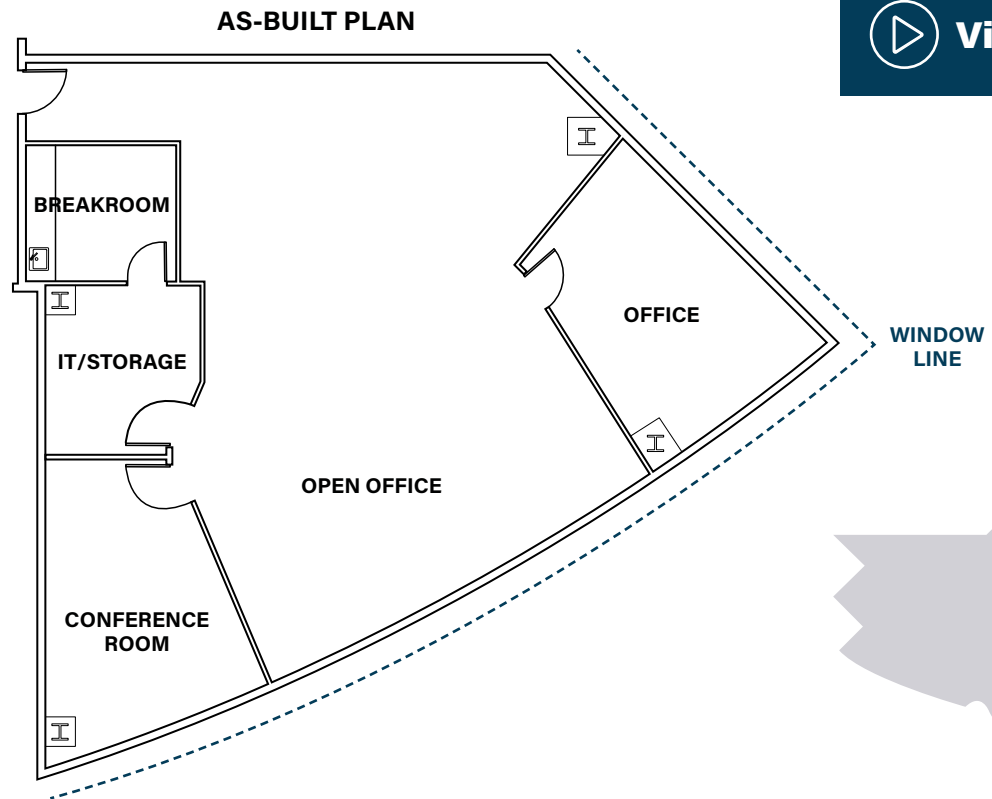



RIO VISTA TOWER

Where Anything is Possible

8880 Rio San Diego Drive
San Diego, CA 92108

www.riovistaoffice.com

Bess Wakeman


Executive Vice President
bess.wakeman@jll.com
+1 858 410 1245
CA RE License #01177659

Tim Olson

Senior Managing Director
tim.olson@jll.com
+1 858 410 1253
CA RE License #01364117

Suite 400 • 18,918 RSF

AS-BUILT PLAN

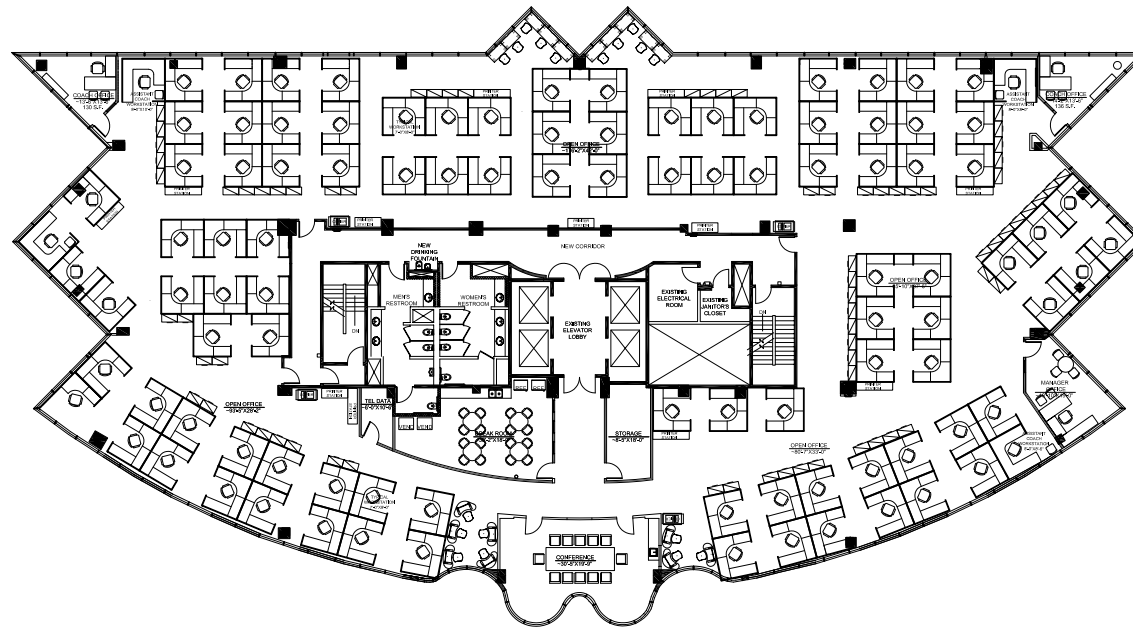



Where Anything is Possible

8880 Rio San Diego Drive
San Diego, CA 92108

www.riovistaoffice.com

Bess Wakeman

Executive Vice President
bess.wakeman@jll.com
+1 858 410 1245
CA RE License #01177659


Tim Olson

Senior Managing Director
tim.olson@jll.com
+1 858 410 1253
CA RE License #01364117

Suite 500 • 17,787 RSF



AS-BUILT PLAN

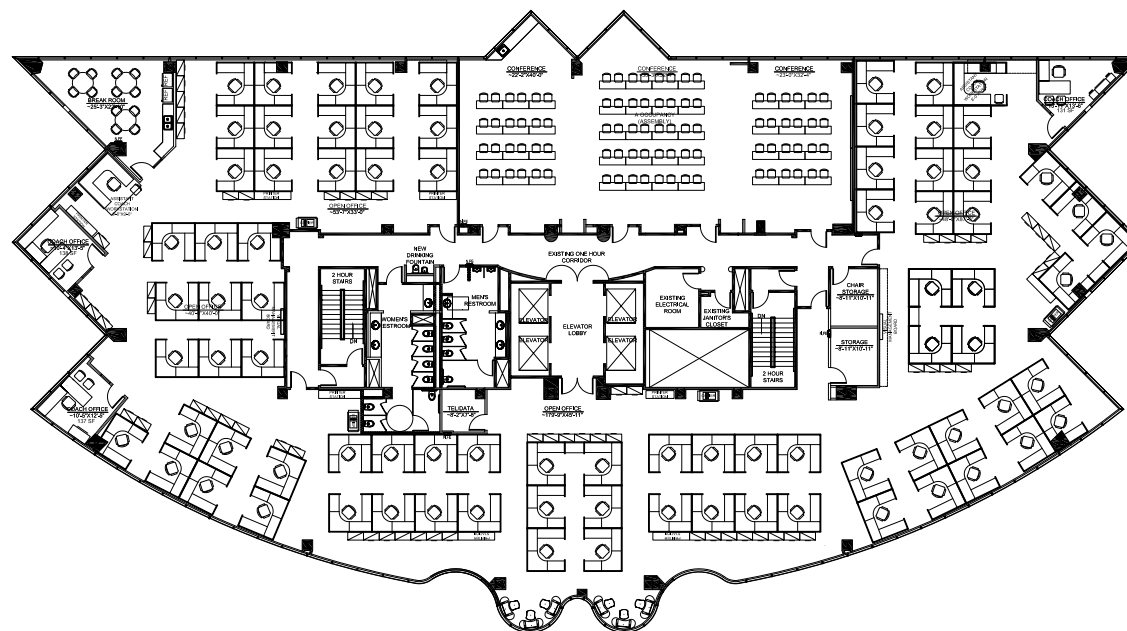



RIO VISTA TOWER

Where Anything is Possible

8880 Rio San Diego Drive
San Diego, CA 92108

www.riovistaoffice.com

Bess Wakeman


Executive Vice President
bess.wakeman@jll.com
+1 858 410 1245
CA RE License #01177659

Tim Olson

Senior Managing Director
tim.olson@jll.com
+1 858 410 1253
CA RE License #01364117

Suite 725 • 2,649 RSF

 **Virtual Tour**

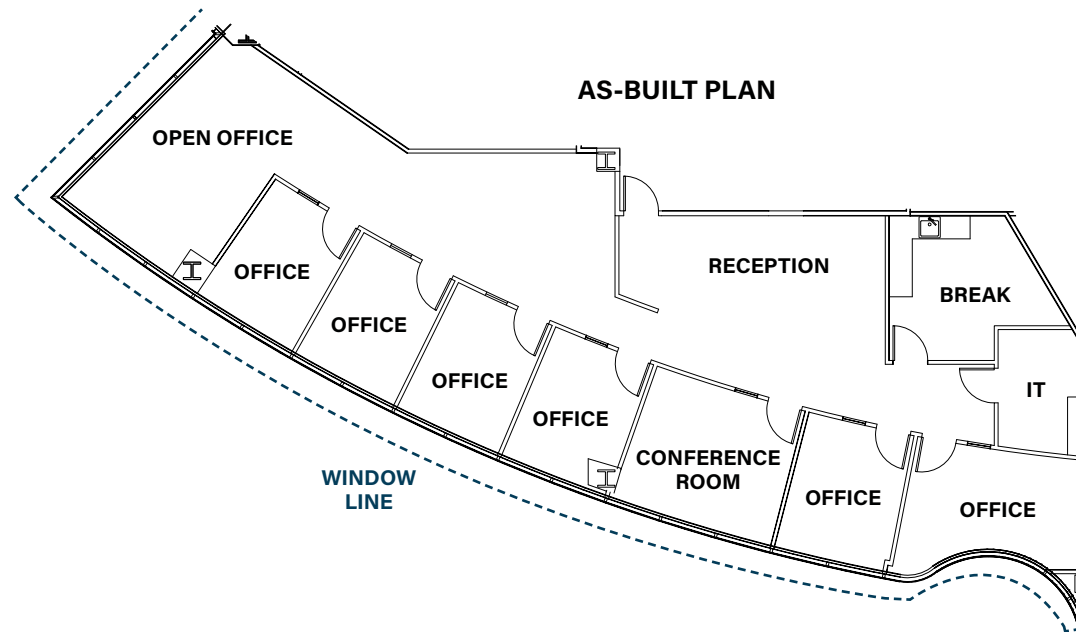



RIO VISTA TOWER

Where Anything is Possible

8880 Rio San Diego Drive
San Diego, CA 92108

www.riovistaoffice.com

Bess Wakeman

Executive Vice President
bess.wakeman@jll.com
+1 858 410 1245
CA RE License #01177659


Tim Olson

Senior Managing Director
tim.olson@jll.com
+1 858 410 1253
CA RE License #01364117

Suite 750 • 5,978 RSF

AS-BUILT PLAN

WINDOW LINE

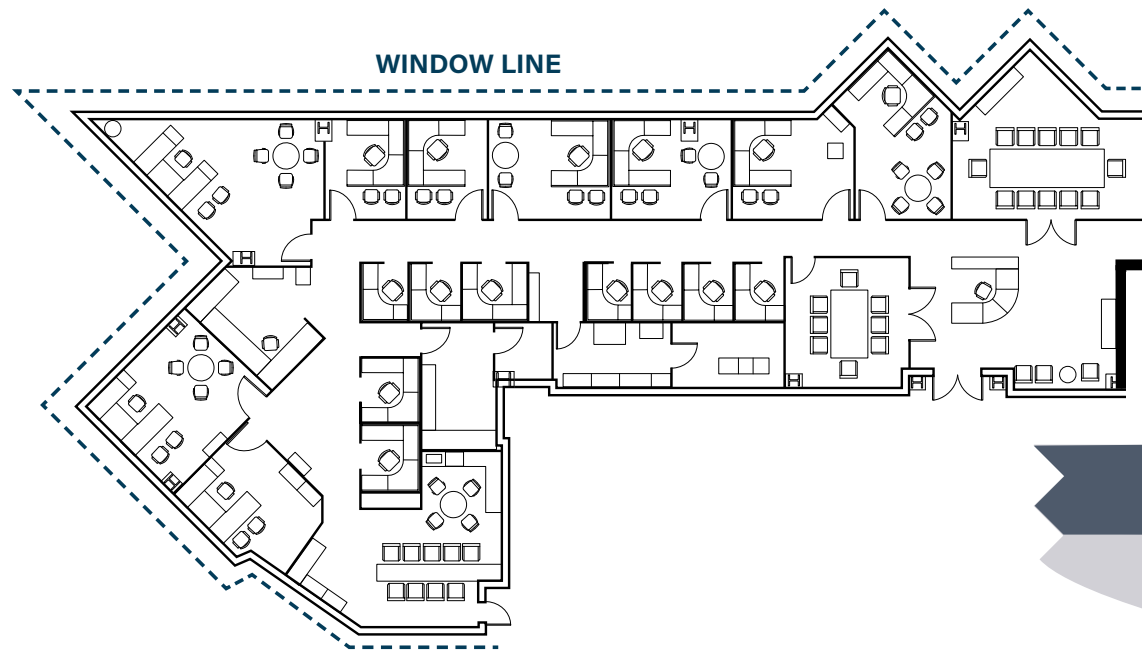



RIO VISTA TOWER

Where Anything is Possible

8880 Rio San Diego Drive
San Diego, CA 92108

www.riovistaoffice.com

Bess Wakeman

Executive Vice President
bess.wakeman@jll.com
+1 858 410 1245
CA RE License #01177659


Tim Olson

Senior Managing Director
tim.olson@jll.com
+1 858 410 1253
CA RE License #01364117

Suite 790 • 2,533 RSF

AS-BUILT PLAN

WINDOW LINE

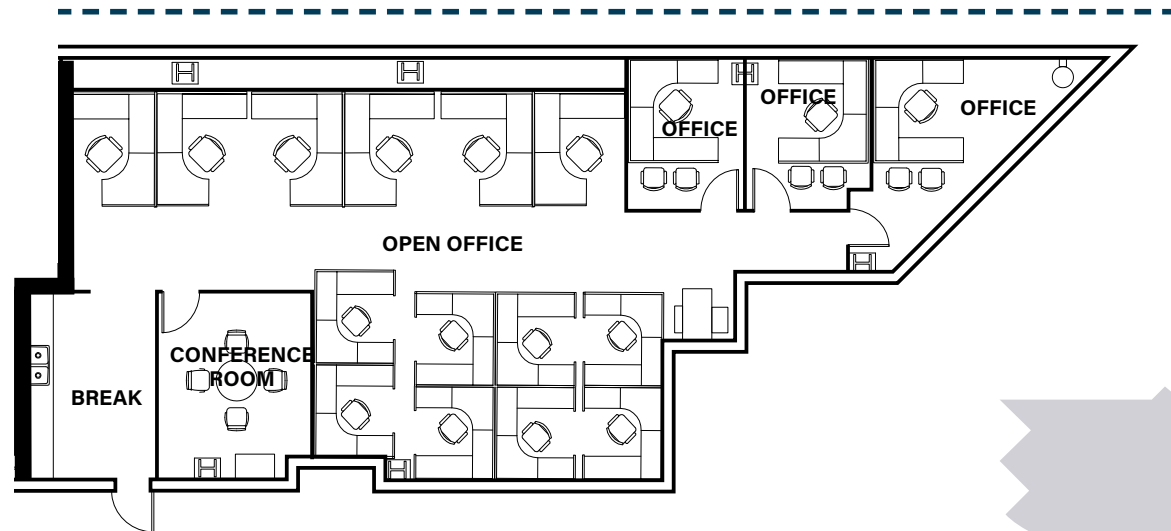



RIO VISTA TOWER

Where Anything is Possible

8880 Rio San Diego Drive
San Diego, CA 92108

www.riovistaoffice.com

Bess Wakeman


Executive Vice President
bess.wakeman@jll.com
+1 858 410 1245
CA RE License #01177659

Tim Olson

Senior Managing Director
tim.olson@jll.com
+1 858 410 1253
CA RE License #01364117

Suite 750 & 790 - 8,511 RSF

AS-BUILT PLAN

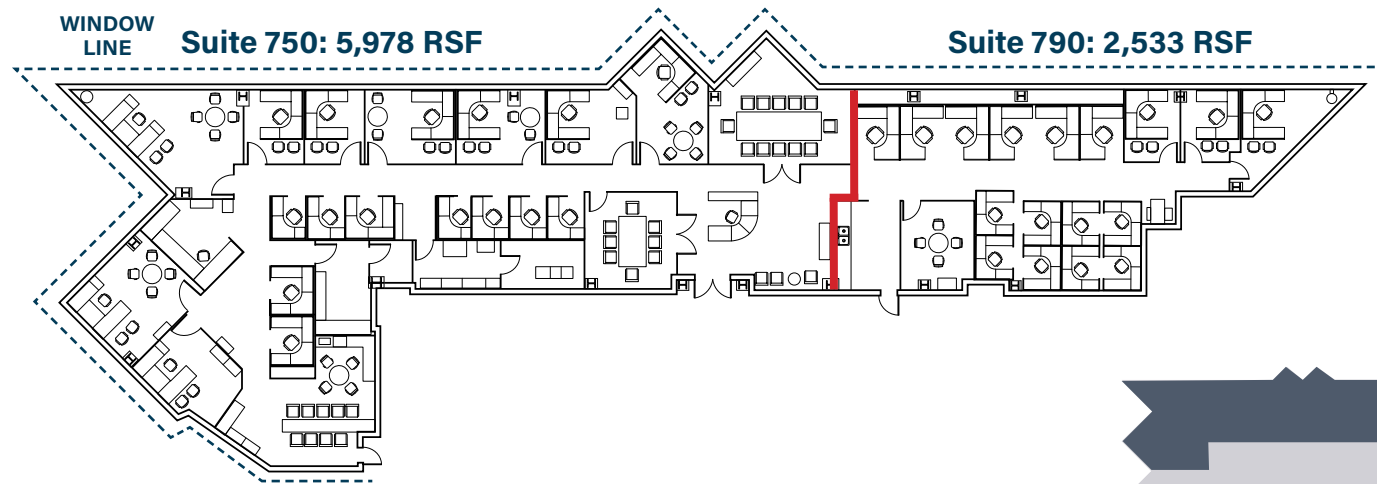

Suite 750



Suite 750



Suite 750



Suite 790



Suite 790



Suite 790



RIO VISTA TOWER

Where Anything is Possible

8880 Rio San Diego Drive
San Diego, CA 92108

www.riovistaoffice.com


Bess Wakeman

Executive Vice President
bess.wakeman@jll.com
+1 858 410 1245
CA RE License #01177659

Tim Olson

Senior Managing Director
tim.olson@jll.com
+1 858 410 1253
CA RE License #01364117

Suite 970 • 2,445 RSF

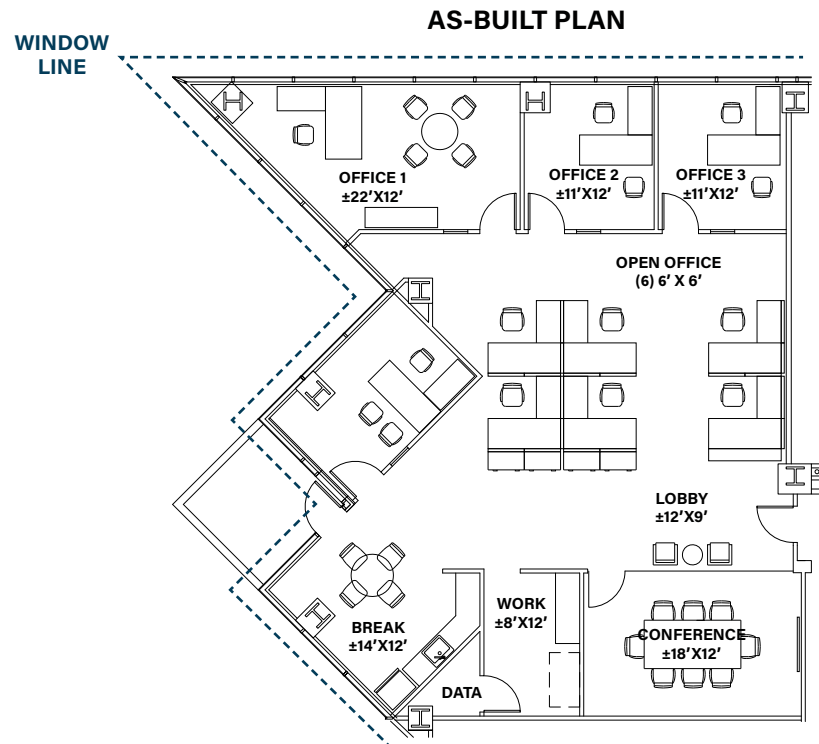

 Virtual Tour





RIO VISTA TOWER

Where Anything is Possible

8880 Rio San Diego Drive
San Diego, CA 92108

www.riovistaoffice.com

Bess Wakeman



Executive Vice President
bess.wakeman@jll.com
+1 858 410 1245
CA RE License #01177659

Tim Olson

Senior Managing Director
tim.olson@jll.com
+1 858 410 1253
CA RE License #01364117

Suite 1150 • 3,471 RSF

 **Virtual Tour**

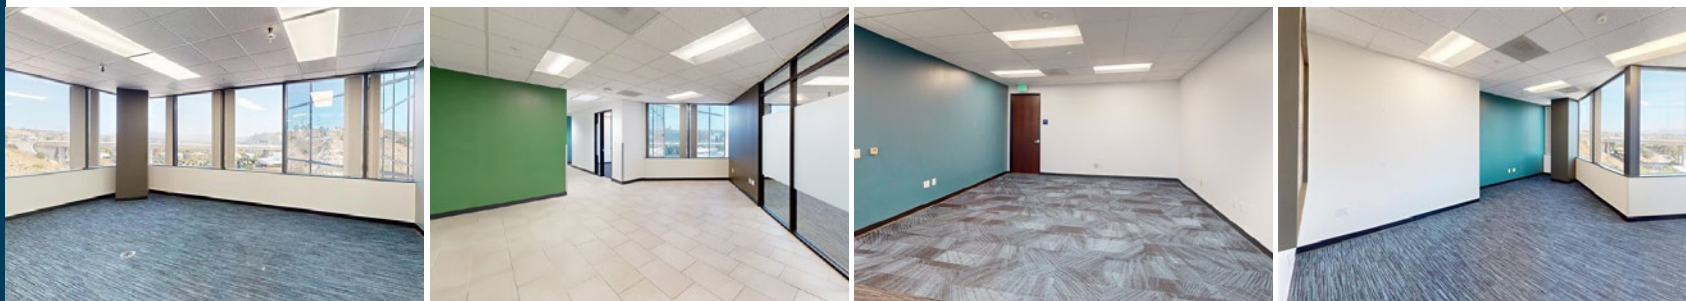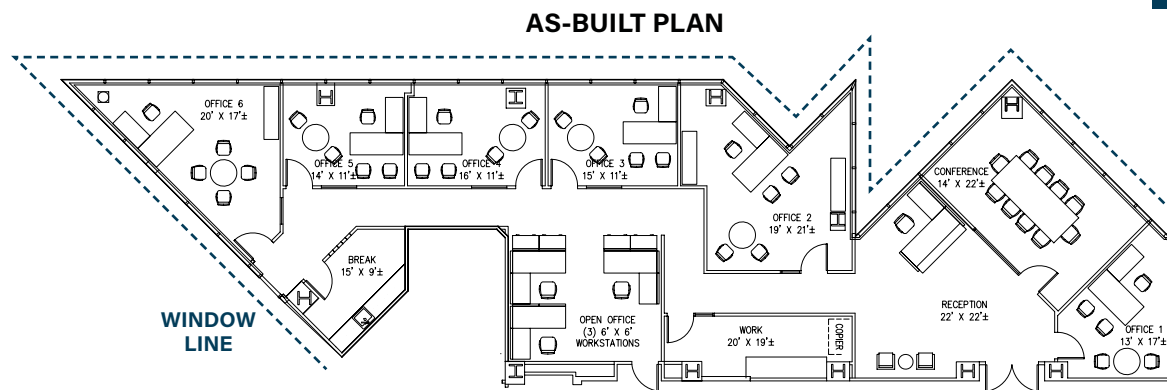



RIO VISTA TOWER

Where Anything is Possible

8880 Rio San Diego Drive
San Diego, CA 92108

www.riovistaoffice.com


Bess Wakeman

Executive Vice President
bess.wakeman@jll.com
+1 858 410 1245
CA RE License #01177659

Tim Olson

Senior Managing Director
tim.olson@jll.com
+1 858 410 1253
CA RE License #01364117

Site Plan

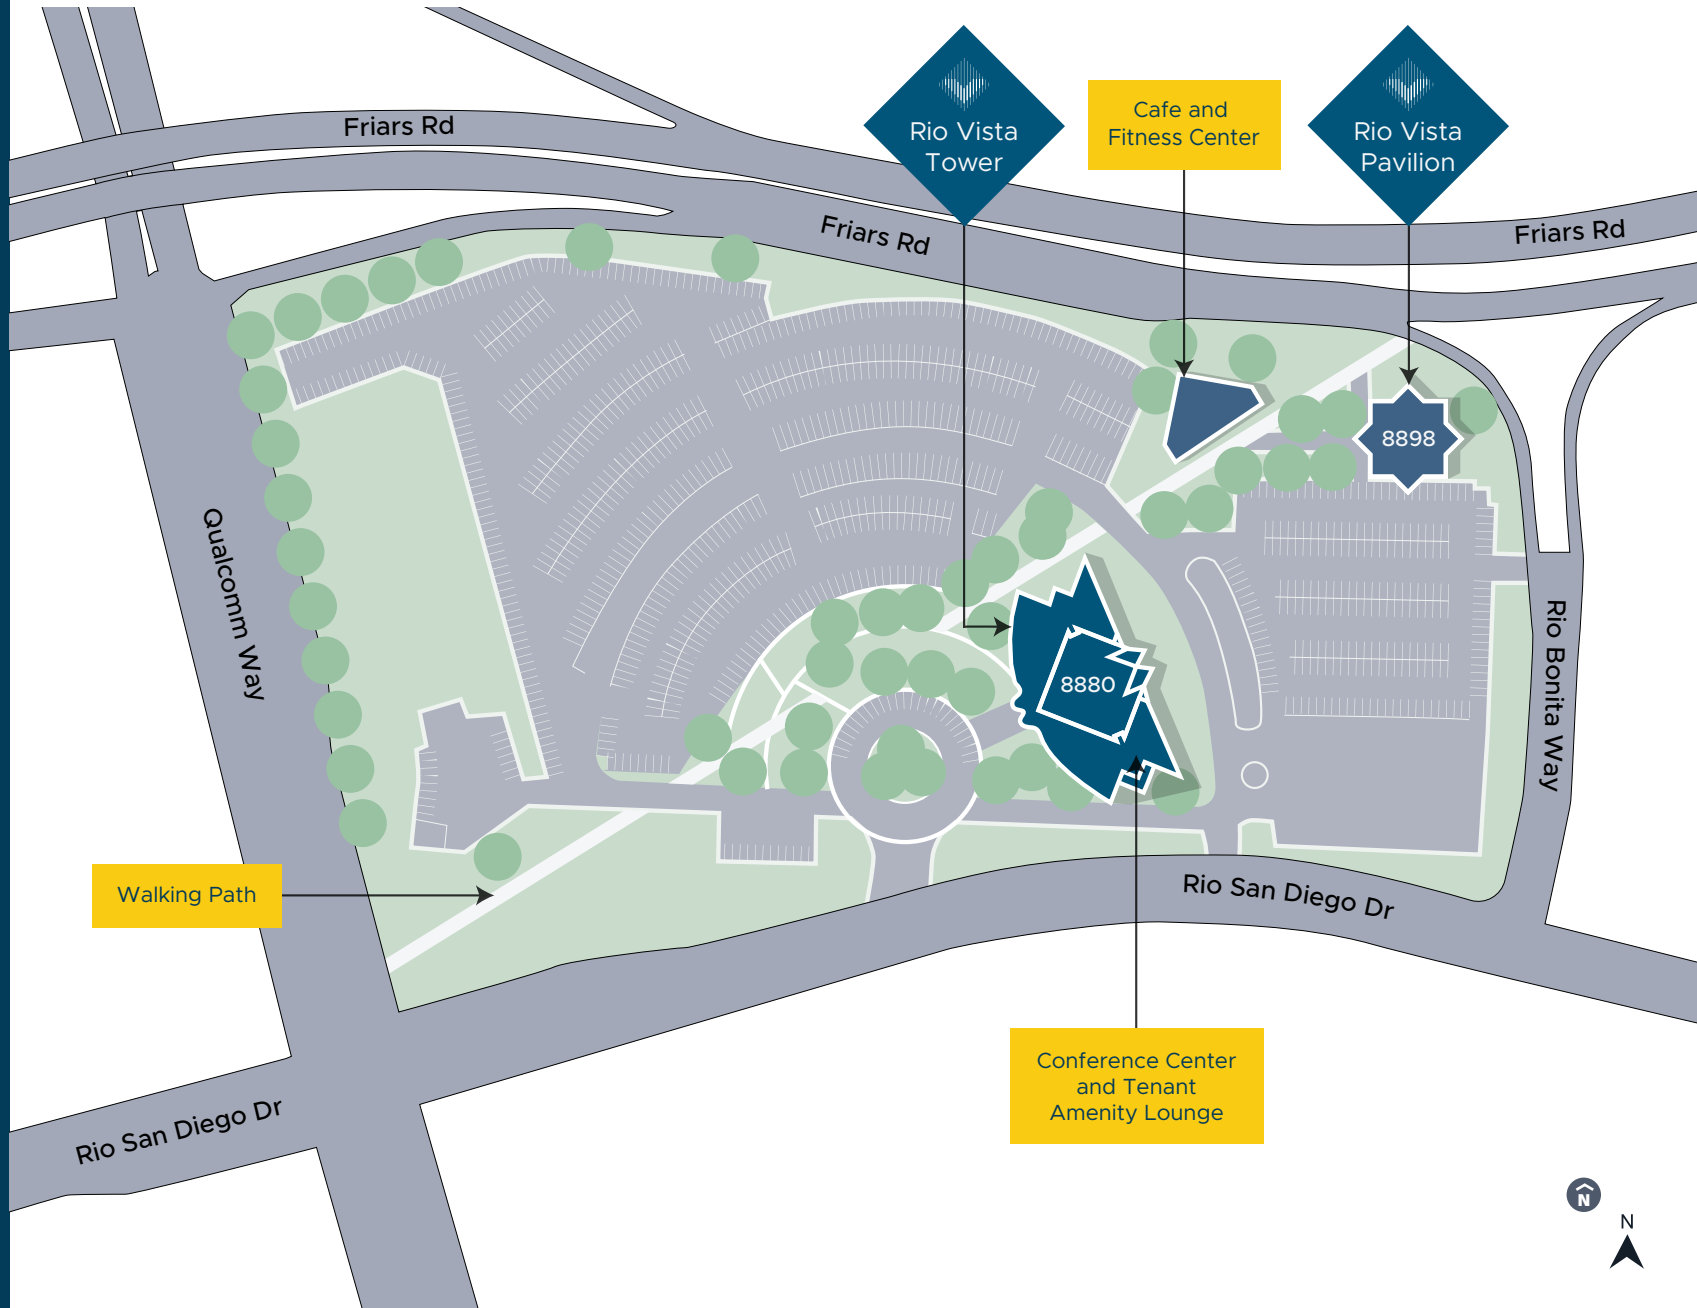



RIO VISTA PAVILION

Where Anything is Possible



Rio Vista Pavilion Offers:



Single occupant building
opportunity



Prominent building top signage
available facing Friars Road



Visitor parking immediately
adjacent to Pavilion



RIO VISTA PAVILION

Where Anything is Possible

8898 Rio San Diego Drive
San Diego, CA 92108

www.riovistaoffice.com

Bess Wakeman

Executive Vice President
bess.wakeman@jll.com
+1 858 410 1245
CA RE License #01177659


Tim Olson

Senior Managing Director
tim.olson@jll.com
+1 858 410 1253
CA RE License #01364117


Floor Plan • 12,193 SF



1st Floor

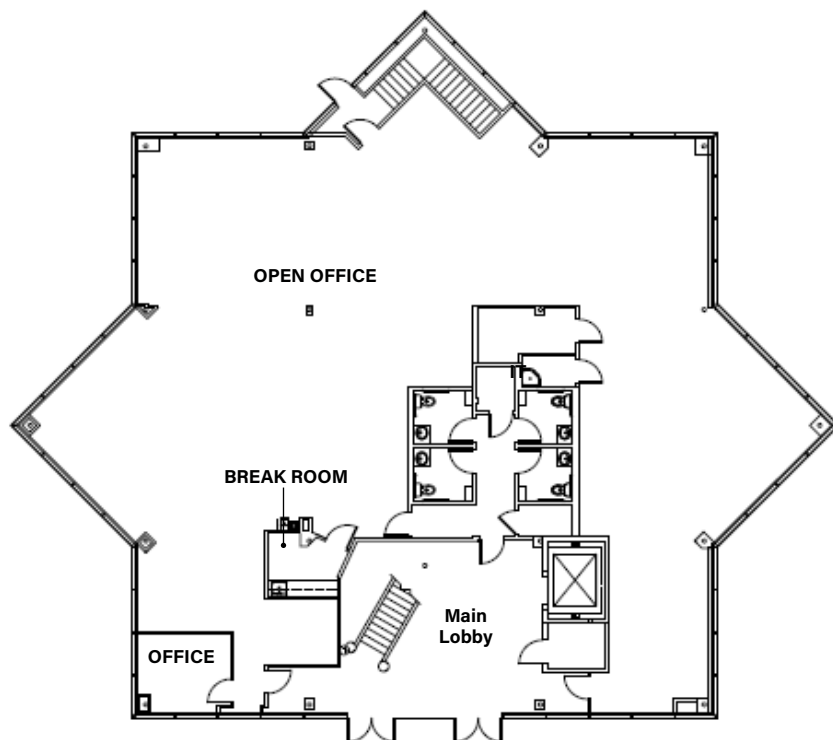

2nd Floor

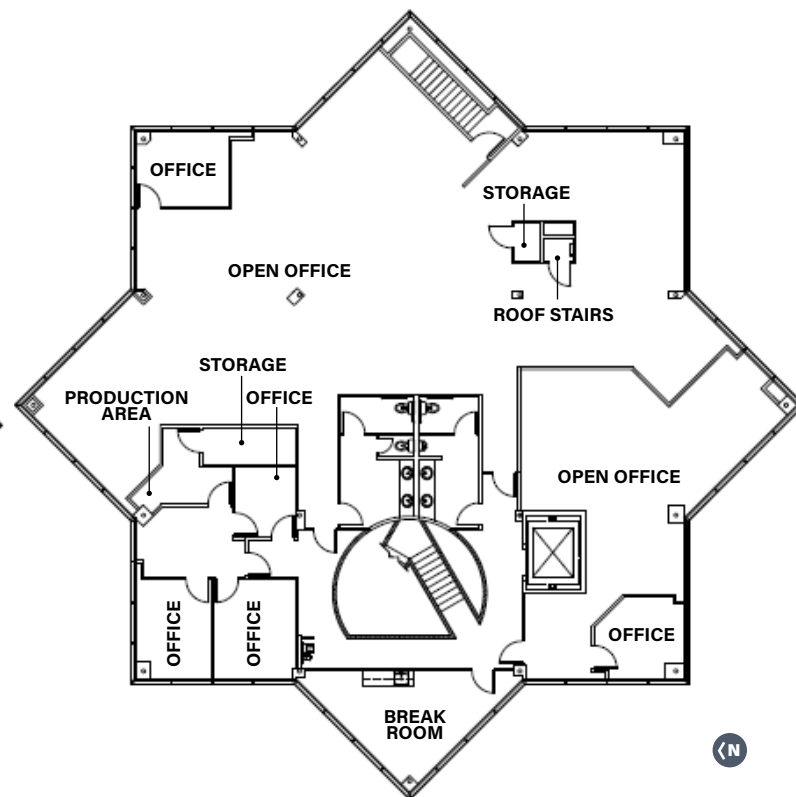

Accessible Location



RIO VISTA
TOWER

5 RIO VISTA
SHOPPING
CENTER

1 MARRIOTT
MISSION
VALLEY

RIO VISTA
STATION

FENTON
PARKWAY
STATION

3 HAZARD
CENTER

HAZARD
CENTER
STATION

MISSION
VALLEY
CENTER
STATION

2 MISSION
VALLEY MALL

4 FASHION
VALLEY MALL

8

805

2 Mission Valley Mall

Buffalo Wild Wings
Chipotle
Corner Bakery
Dairy Queen
Onami Seafood
Outback Steakhouse
Panda Express
Panera Bread
Pei Wei Asian Diner
Starbucks
Target
Tender Greens
The Broken Yolk
Wetzel's Pretzels

3 Hazard Center

BJ's Restaurant
Orange Theory
Fitness
Smashburger
Starbucks
Which Wich
Wood Ranch BBQ
Yogurtland

4 Fashion Valley Mall

Bloomingdale's
Better Buzz Coffee
Blanco Tacos
Cheesecake Factory
Haagen-Dazs
Nordstrom Cafe
North Italia
Panda Express
P.F. Chang's
Pinkberry
Pressed Juicery
Pure Burger
Starbucks
True Food Kitchen

5 Rio Vista Shopping Center

Jersey Mikes
T.J. Maxx
McDonald's
Oggi's Pizza
Sushi Kuchi
Starbucks

6 Fenton Marketplace

Cold Stone Creamery
IHOP
Ka Prao Thai Cuisine
Living Spaces
Party City
Wendy's

7 SnapDragon Stadium and SDSU Mission Valley Campus

7 SNAPDRAGON
STADIUM

SDSU MISSION
VALLEY CAMPUS

STADIUM
STATION

6 FENTON
MARKETPLACE

RIO SAN DIEGO DR

FRIARS ROAD

SAN DIEGO RIVER

CAMINO DEL RIO N

CAMINO DE LA REINA

TEXAS STREET

MISSION CENTER

QUALCOMM WAY

RIO VISTA
STATION



RIO VISTA

TOWER

Where Anything is Possible

8880 Rio San Diego Drive
San Diego, CA 92108

www.riovistaoffice.com

Bess Wakeman

Executive Vice President
bess.wakeman@jll.com
+1 858 410 1245
CA RE License #01177659

Tim Olson

Senior Managing Director
tim.olson@jll.com
+1 858 410 1253
CA RE License #01364117

