




MISSION CITY

2365 NORTHSIDE DRIVE

SUITE 300 | 16,403 RSF

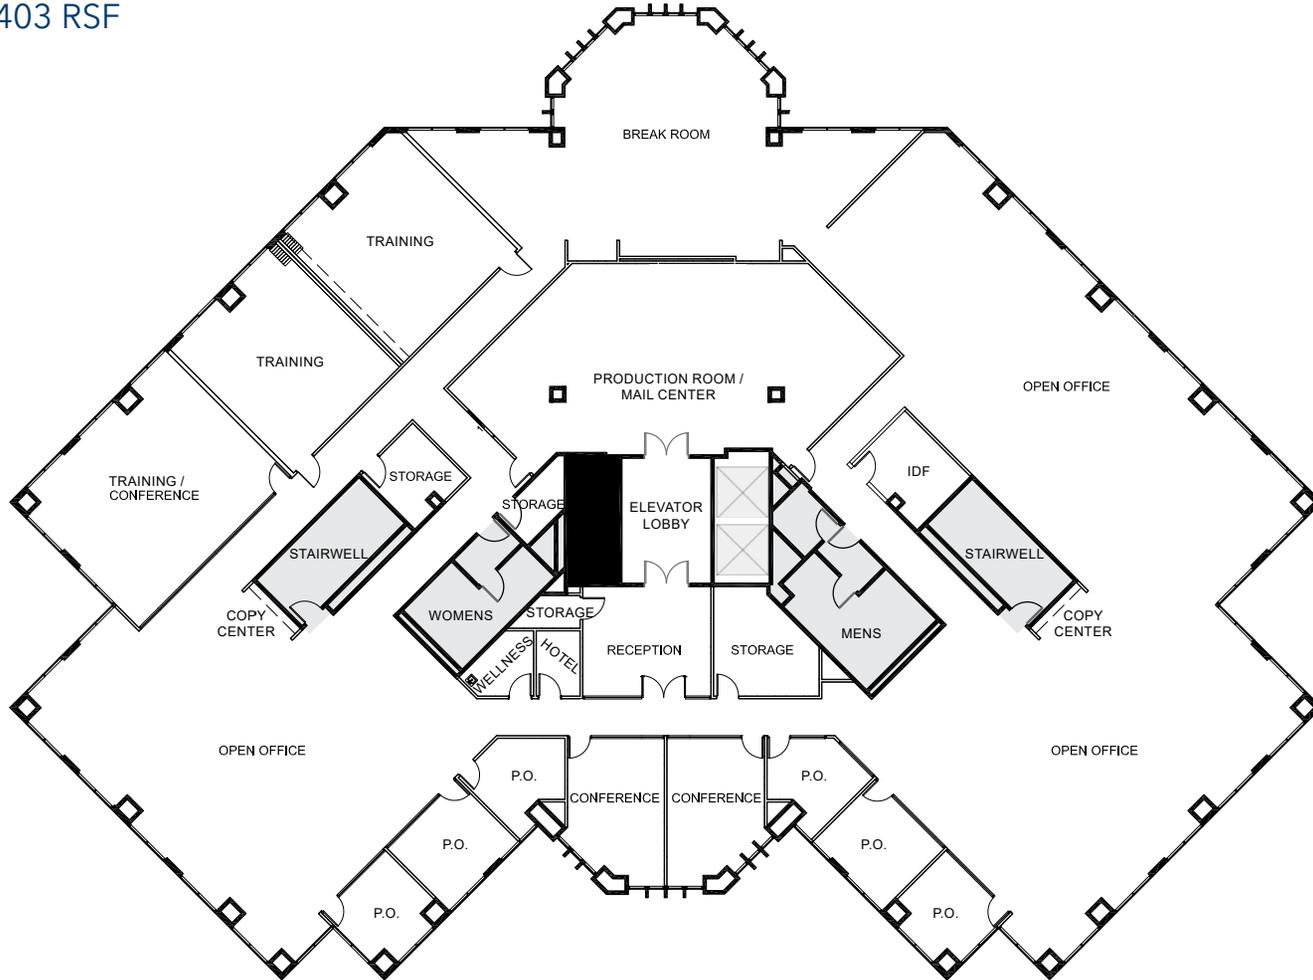

BESS WAKEMAN

+1 858 410 1245
bess.wakeman@jll.com
RE license #01177659

TIM OLSON

+1 858 410 1253
tim.olson@jll.com
RE license #01364117






MISSION CITY


2365 NORTHSIDE DRIVE

SUITE 500 | 3,452 RSF

AS BUILT

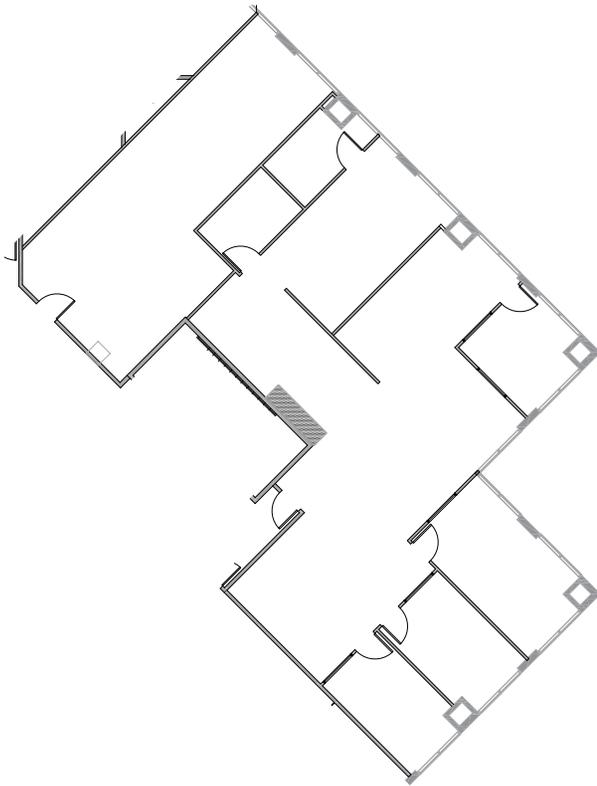

PROPOSED LAYOUT

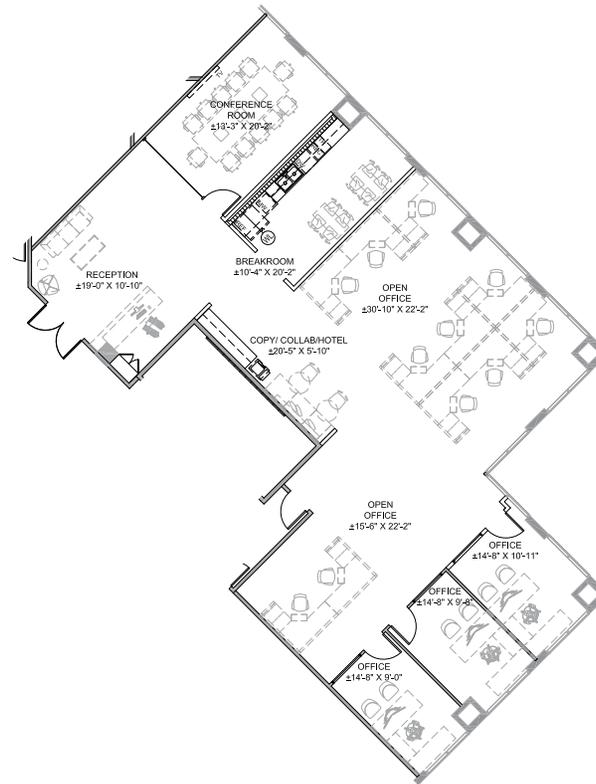

BESS WAKEMAN
+1 858 410 1245
bess.wakeman@jll.com
RE license #01177659

TIM OLSON
+1 858 410 1253
tim.olson@jll.com
RE license #01364117

