

MIDD BLOCK




6 SUMMIT
CAPITAL

2401 DISTRIBUTION

AS-BUILT PLAN

±5,019 - 20,334 RSF

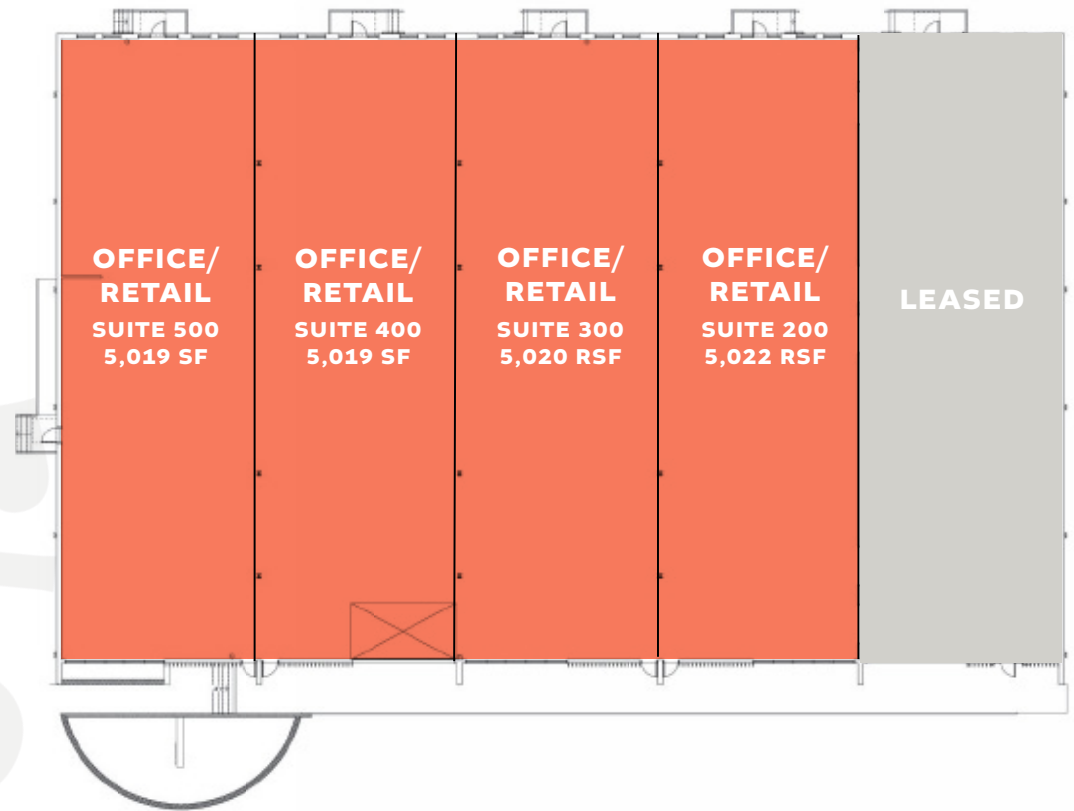

DISTRIBUTION STREET