

MISSION TRAILS INDUSTRIAL PARK

7385 MISSION GORGE ROAD | SAN DIEGO, CA

SUBLEASE RATE
\$1.25 NNN



44,739 SF WAREHOUSE | DISTRIBUTION | PRODUCTION
AVAILABLE FOR SUBLEASE
100% Temperature Controlled




Jones Lang LaSalle Brokerage, Inc.
RE License #01856260

SITE PLAN & FEATURES



- Full concrete truck court
- Excellent truck access with full drive around
- Located within a $\pm 650,000$ SF industrial park
- offering expansion opportunities
- Easy access to I-8, I-805 & I-15
- Mission Gorge Frontage
- Extensive landscaping throughout
- 1.3/1,000 parking ratio
- Gas to the building
- Fully air conditioned

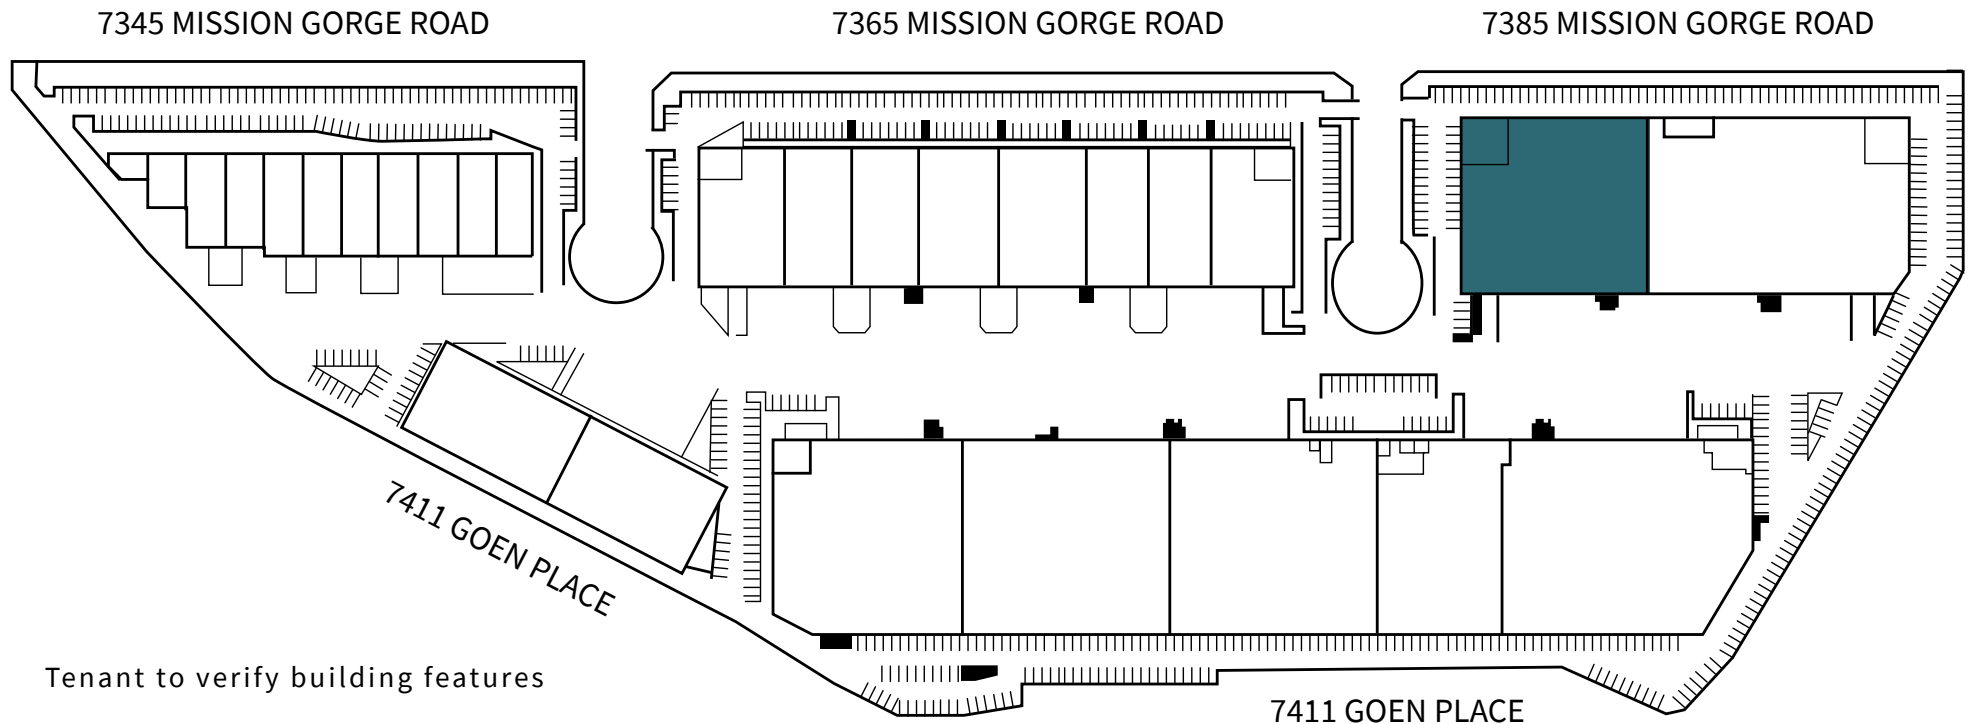



AS-BUILT FLOOR PLAN

TOTAL BUILDING AREA	± 44,739 SF
OFFICE	± 9,000 SF
DOCK DOORS	6 (expandable to 8)
GRADE DOORS	1
PIT & DOCK LEVELERS	4 pit levelers & 2 edge of dock levelers
CLEAR HEIGHT	28' minimum
SPRINKLER	.5/2,000 GPM capacity
PRICING	Contact Broker for Pricing
NETS	\$0.30 PSF
AVAILABLE	08/01/2026
SUBLEASE TERM	Through 07/31/2029

Tenant to verify building features

- GRADE DOOR
- ▲ DOCK DOOR
- EXPANSION DOCK DOOR(S)

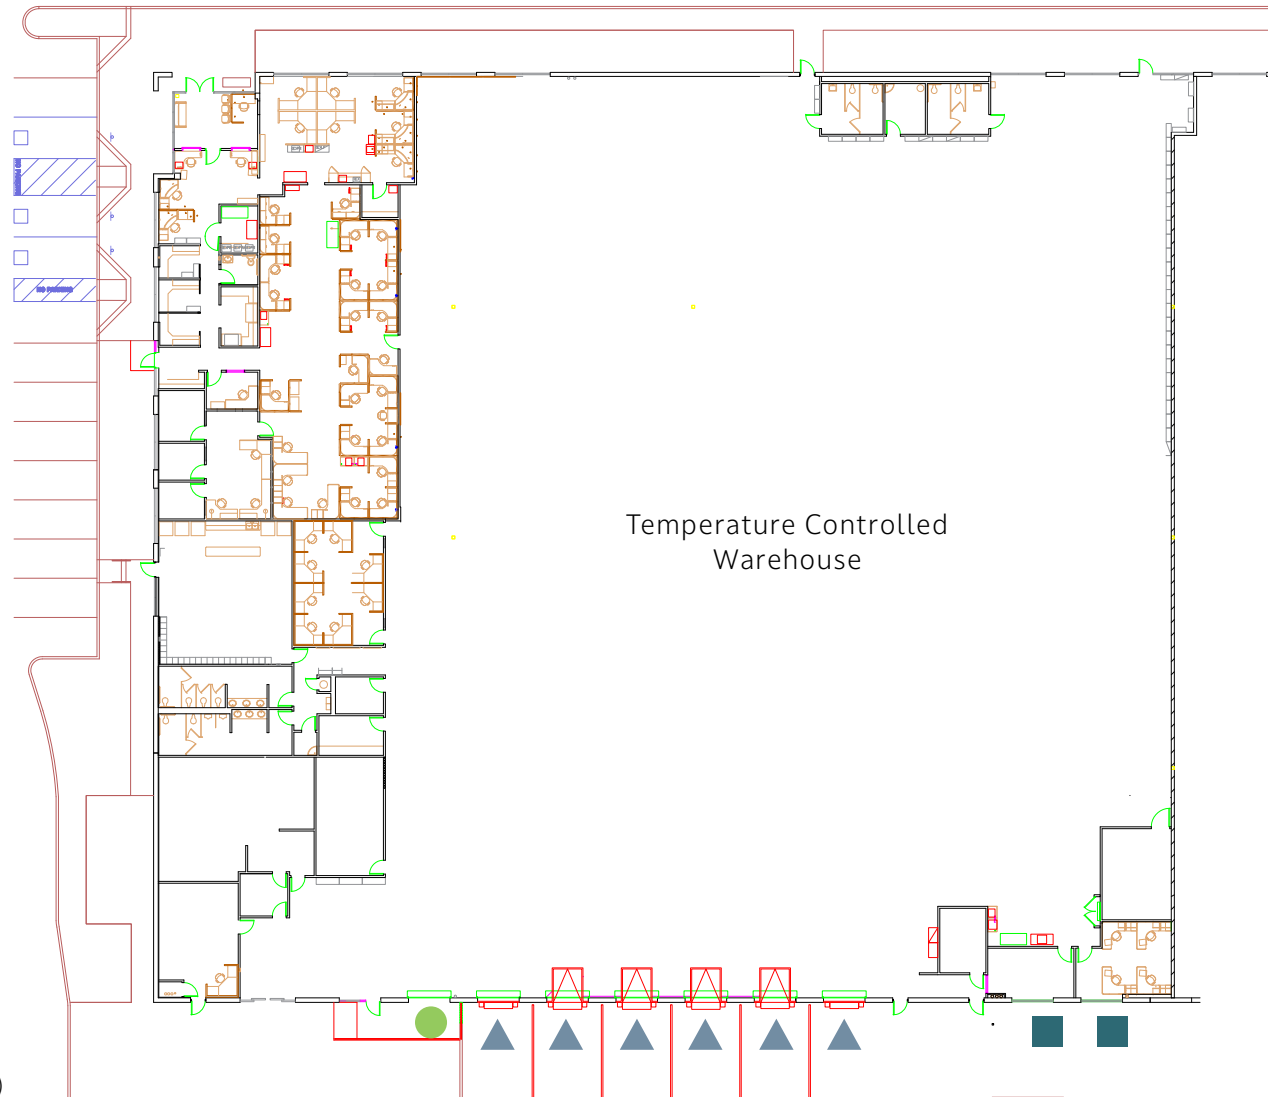

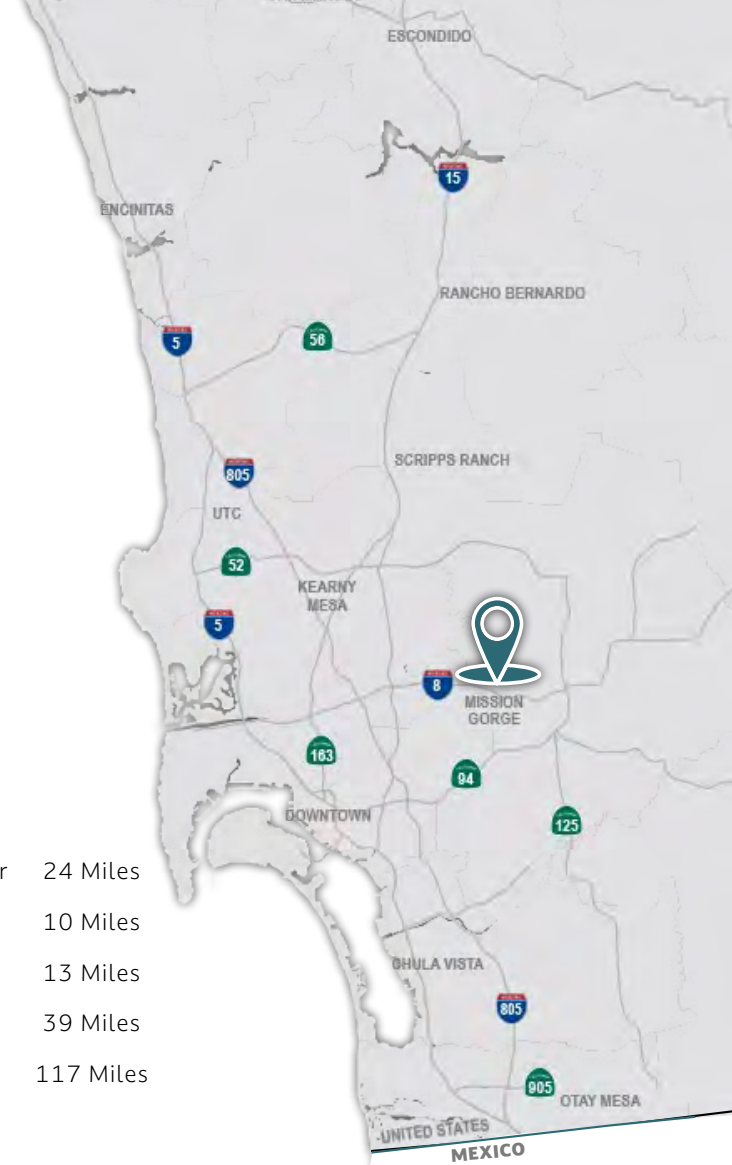

DRIVE TIMES

Mexico Border	24 Miles
Downtown	10 Miles
Airport	13 Miles
Oceanside	39 Miles
Long Beach	117 Miles

Kevin Leissring

+1 858 410 1242
kevin.leissring@jll.com
RE Lic. #02088596

Andy Irwin

+1 858 410 6376
andy.irwin@jll.com
RE Lic. #01302674

Shawn Lorentzen

+1 858 410 1222
shawn.lorentzen@jll.com
RE Lic. #01429583

Greg Lewis

+1 858 410 1251
greg.lewis@jll.com
RE Lic. #013656002

Although information has been obtained from sources deemed reliable, neither Owner nor JLL makes any guarantees, warranties or representations, express or implied, as to the completeness or accuracy as to the information contained herein. Any projections, opinions, assumptions or estimates used are for example only. There may be differences between projected and actual results, and those differences may be material. The Property may be withdrawn without notice. Neither Owner nor JLL accepts any liability for any loss or damage suffered by any party resulting from reliance on this information. If the recipient of this information has signed a confidentiality agreement regarding this matter, this information is subject to the terms of that agreement. © 2026 Jones Lang LaSalle IP, Inc. All rights reserved.

