



9980 HUENNEKENS STREET

SUITE 100/200
LEVEL 1 | 15,702 SF
AS-BUILT PLAN

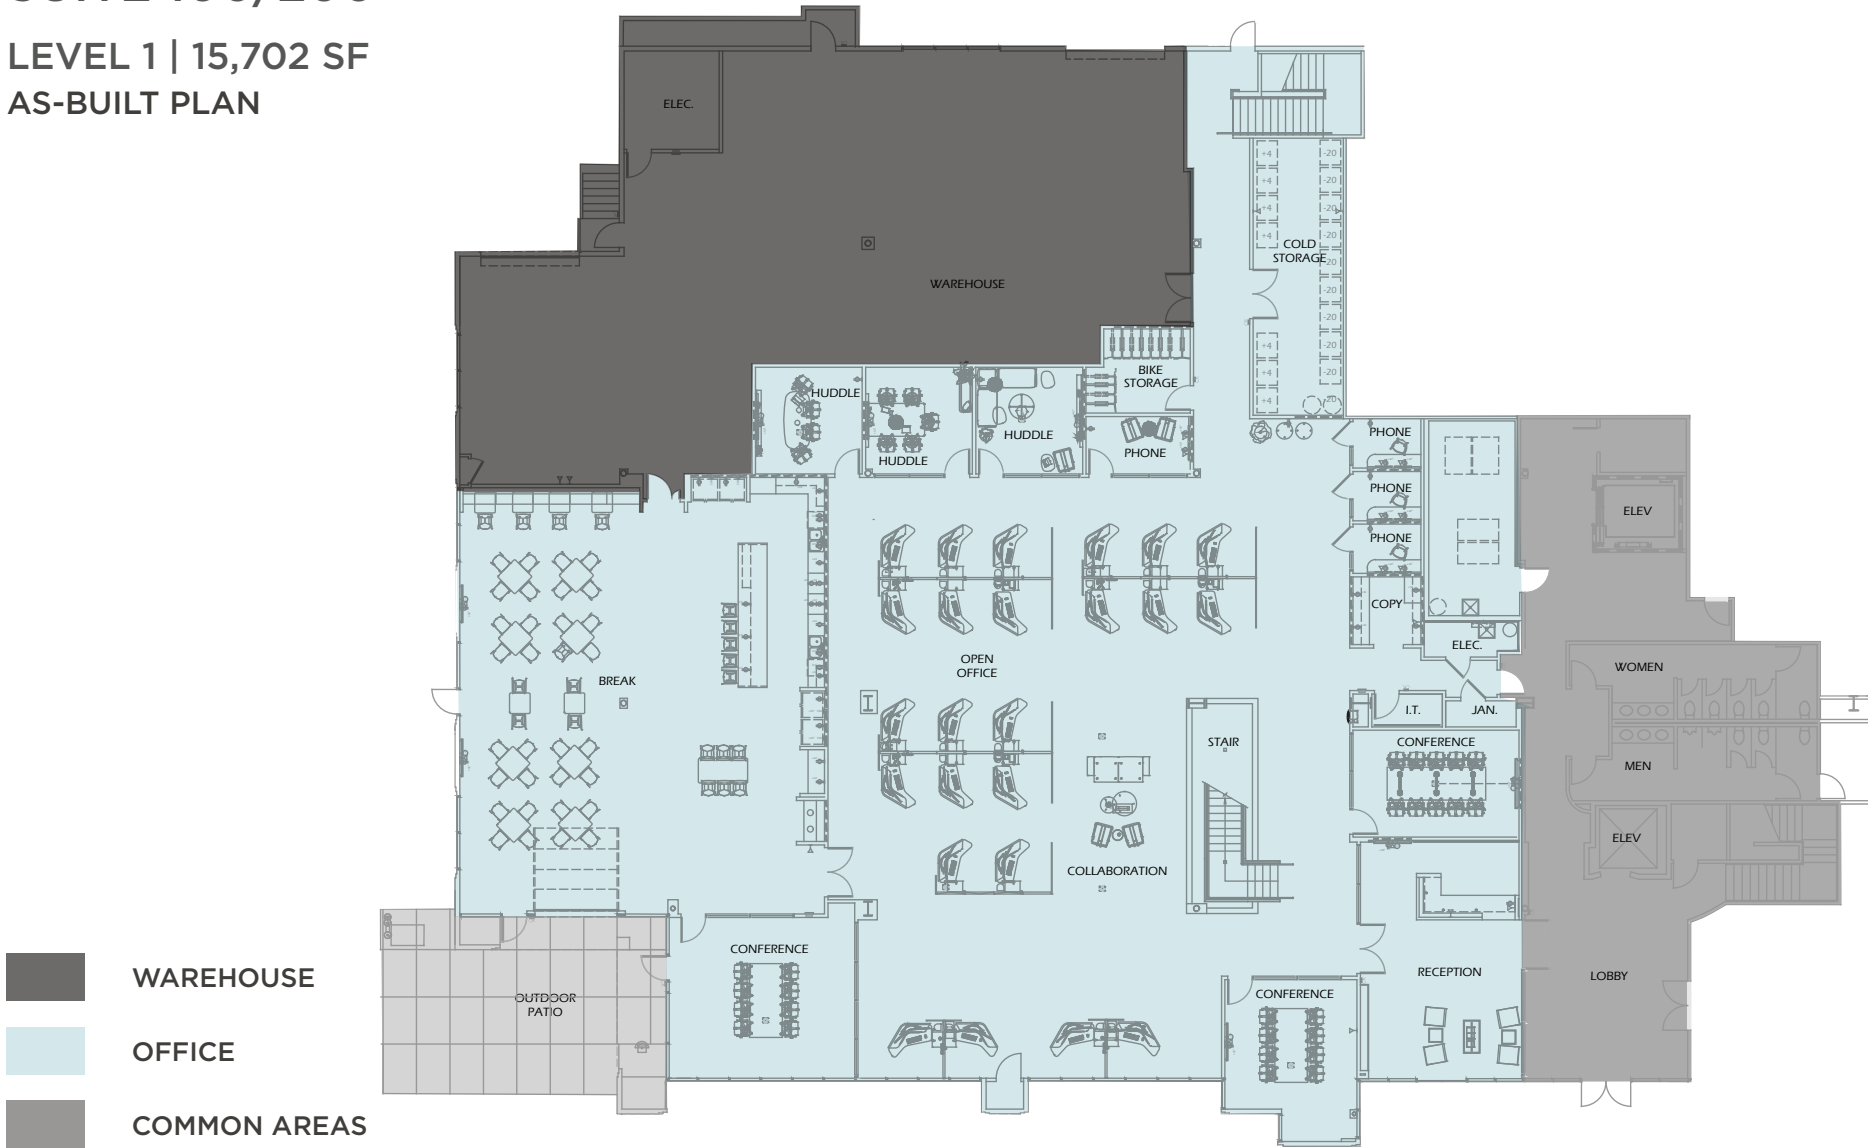

9980 HUENNEKENS STREET

SUITE 100/200
LEVEL 2 | 16,260 SF
AS-BUILT PLAN

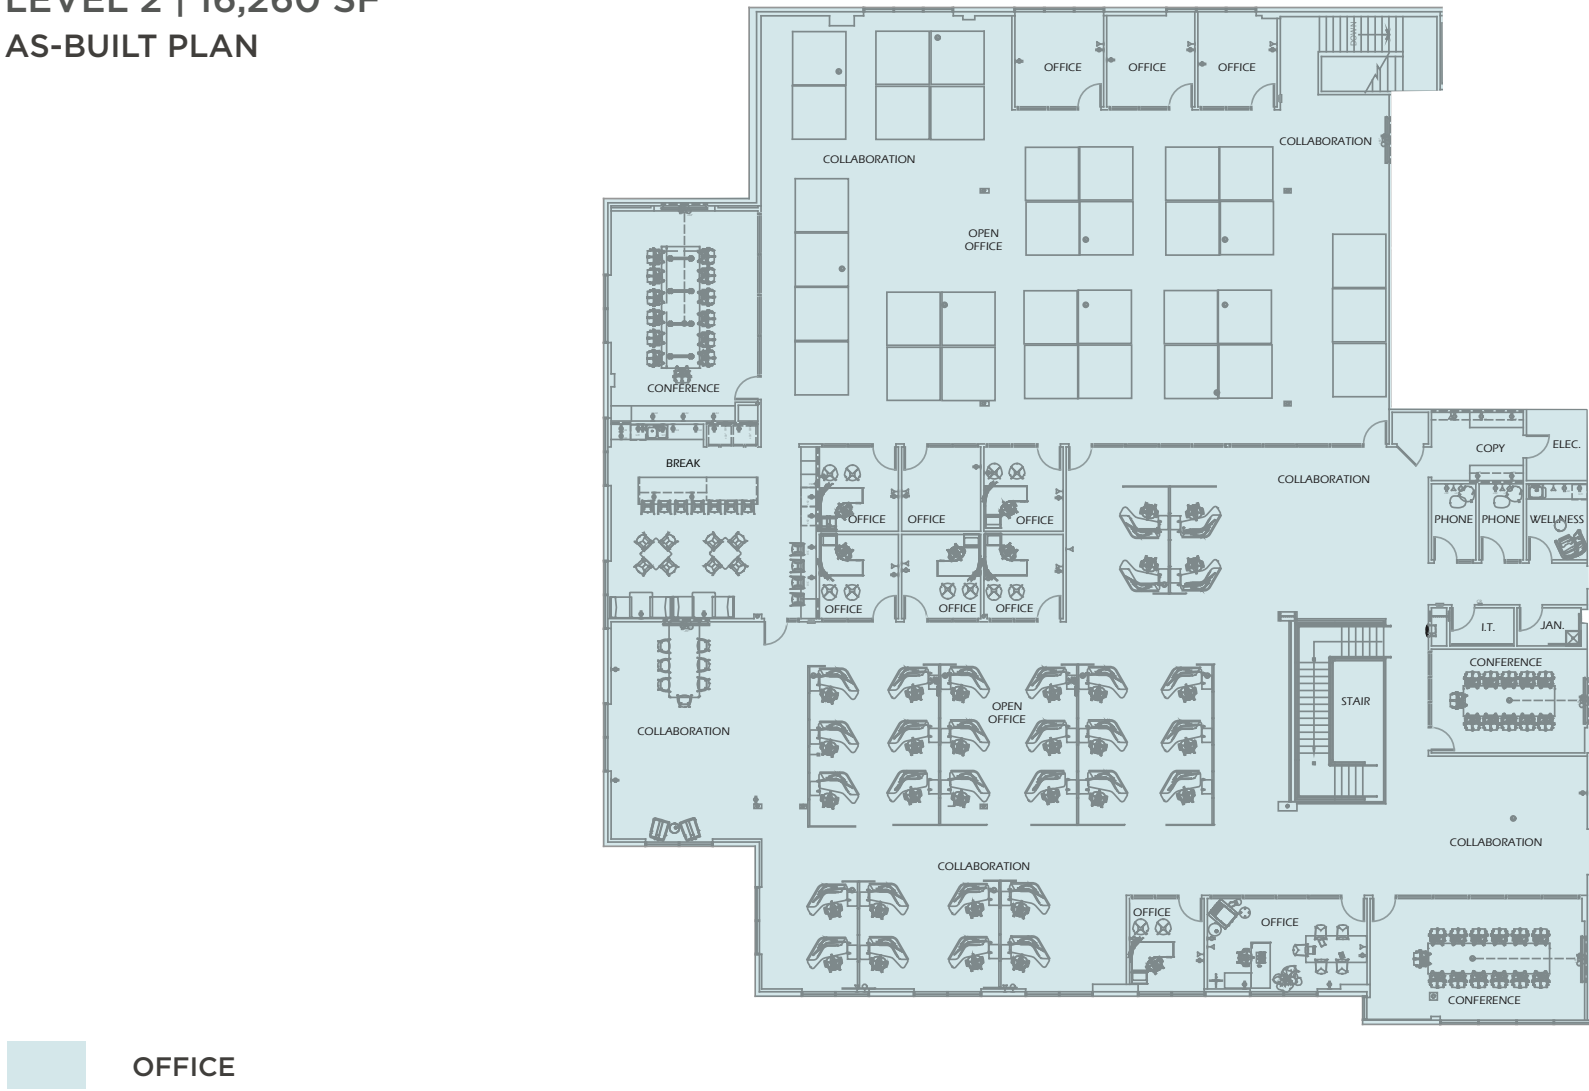

9980 HUENNEKENS STREET

SUITE 140
13,684 SF
LEVEL 1
AS-BUILT PLAN




OFFICE

*FURNITURE NOT INCLUDED

9980 HUENNEKENS STREET

SUITE 250
15,171 SF
50% Lab | 50% Office
AS-BUILT PLAN

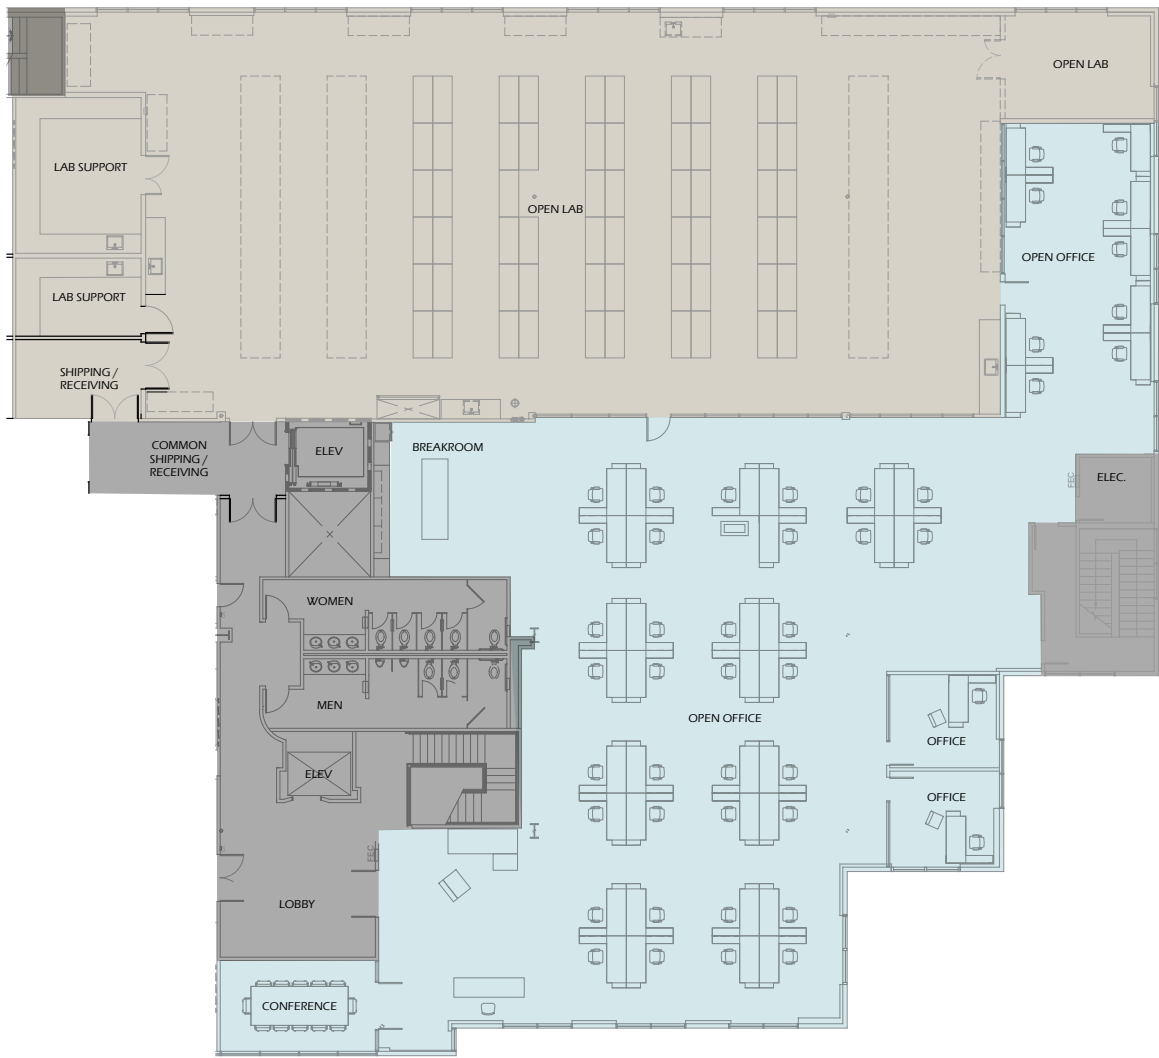

OFFICE
LAB
COMMON AREAS
FUTURE BUILD-OUT

*FURNITURE NOT INCLUDED