



SUITE 150 | 5,231 RSF

AS BUILT

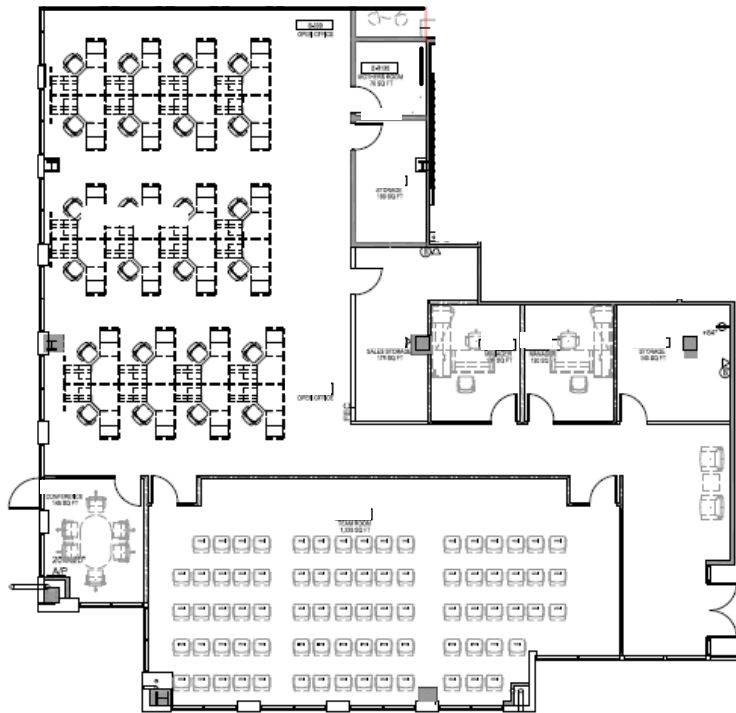


PLANNED BUILDOUT DELIVERING Q2 2026

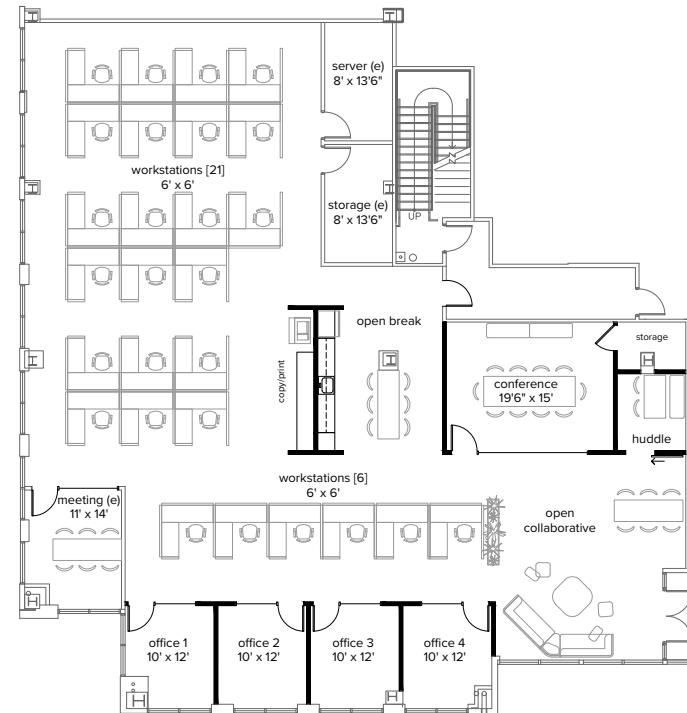

BESS WAKEMAN
+1 858 410 1245
bess.wakeman@jll.com
RE license #01177659

TIM OLSON
+1 858 410 1253
tim.olson@jll.com
RE license #01364117

SUITE 270 | 6,659 RSF | Available 12/1/26

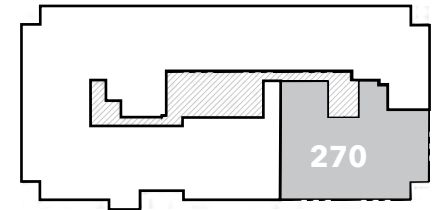

BESS WAKEMAN
+1 858 410 1245
bess.wakeman@jll.com
RE license #01177659

TIM OLSON
+1 858 410 1253
tim.olson@jll.com
RE license #01364117