




TWENTY
GREENWAY
www.20-greenway.com

- Suite 300
- 17,602 RSF
- As-built plan
- Access to amenities include conferencing, fitness, gameroom and deli

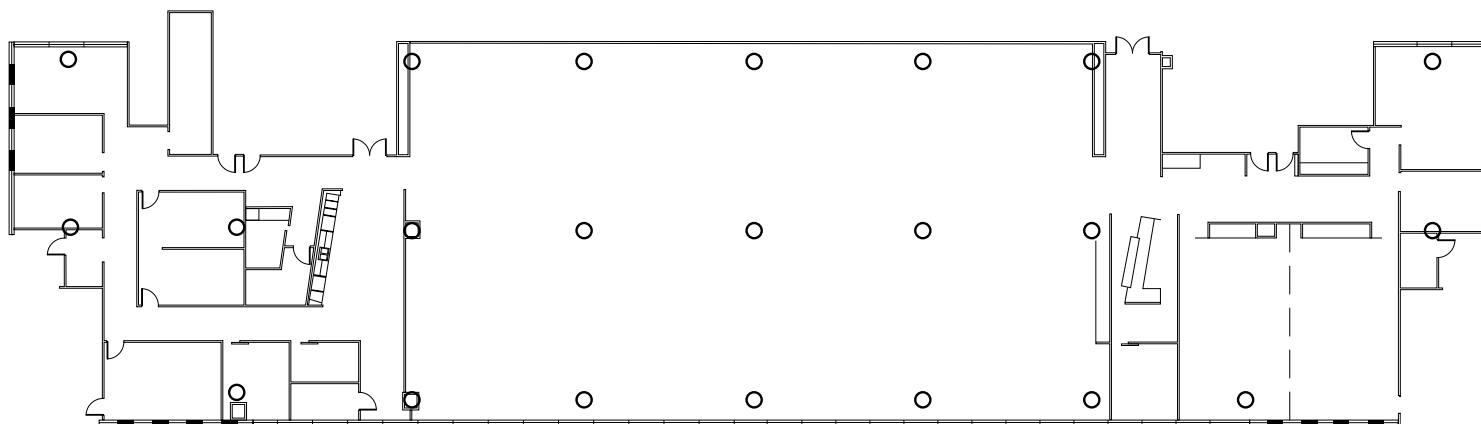

LEASING
CONTACTS:

Tyler Garrett
tyler.garret@jll.com
+1 713 425 1802

Jack Russo
jack.russo@jll.com
+1 713 425 1808



STOCKDALE
CAPITAL PARTNERS

