


First Floor As-Built Plan



Second Floor As-Built Plan

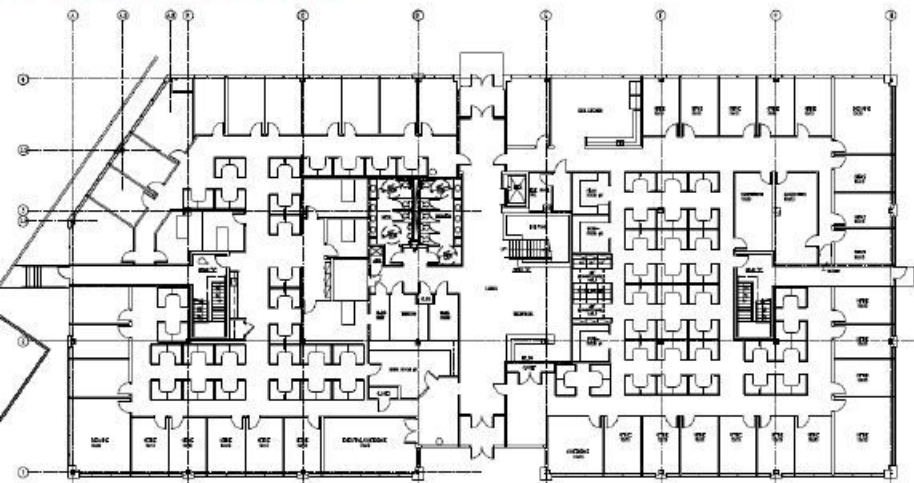