


AS-BUILT CONFIGURATION

OFFICES.....	4
RECEPTION.....	1
CONFERENCE ROOMS.....	3
KITCHEN.....	1
OPEN WORK AREA.....	+/- 125

Not to scale, furniture and appliances not included

KEY PLAN

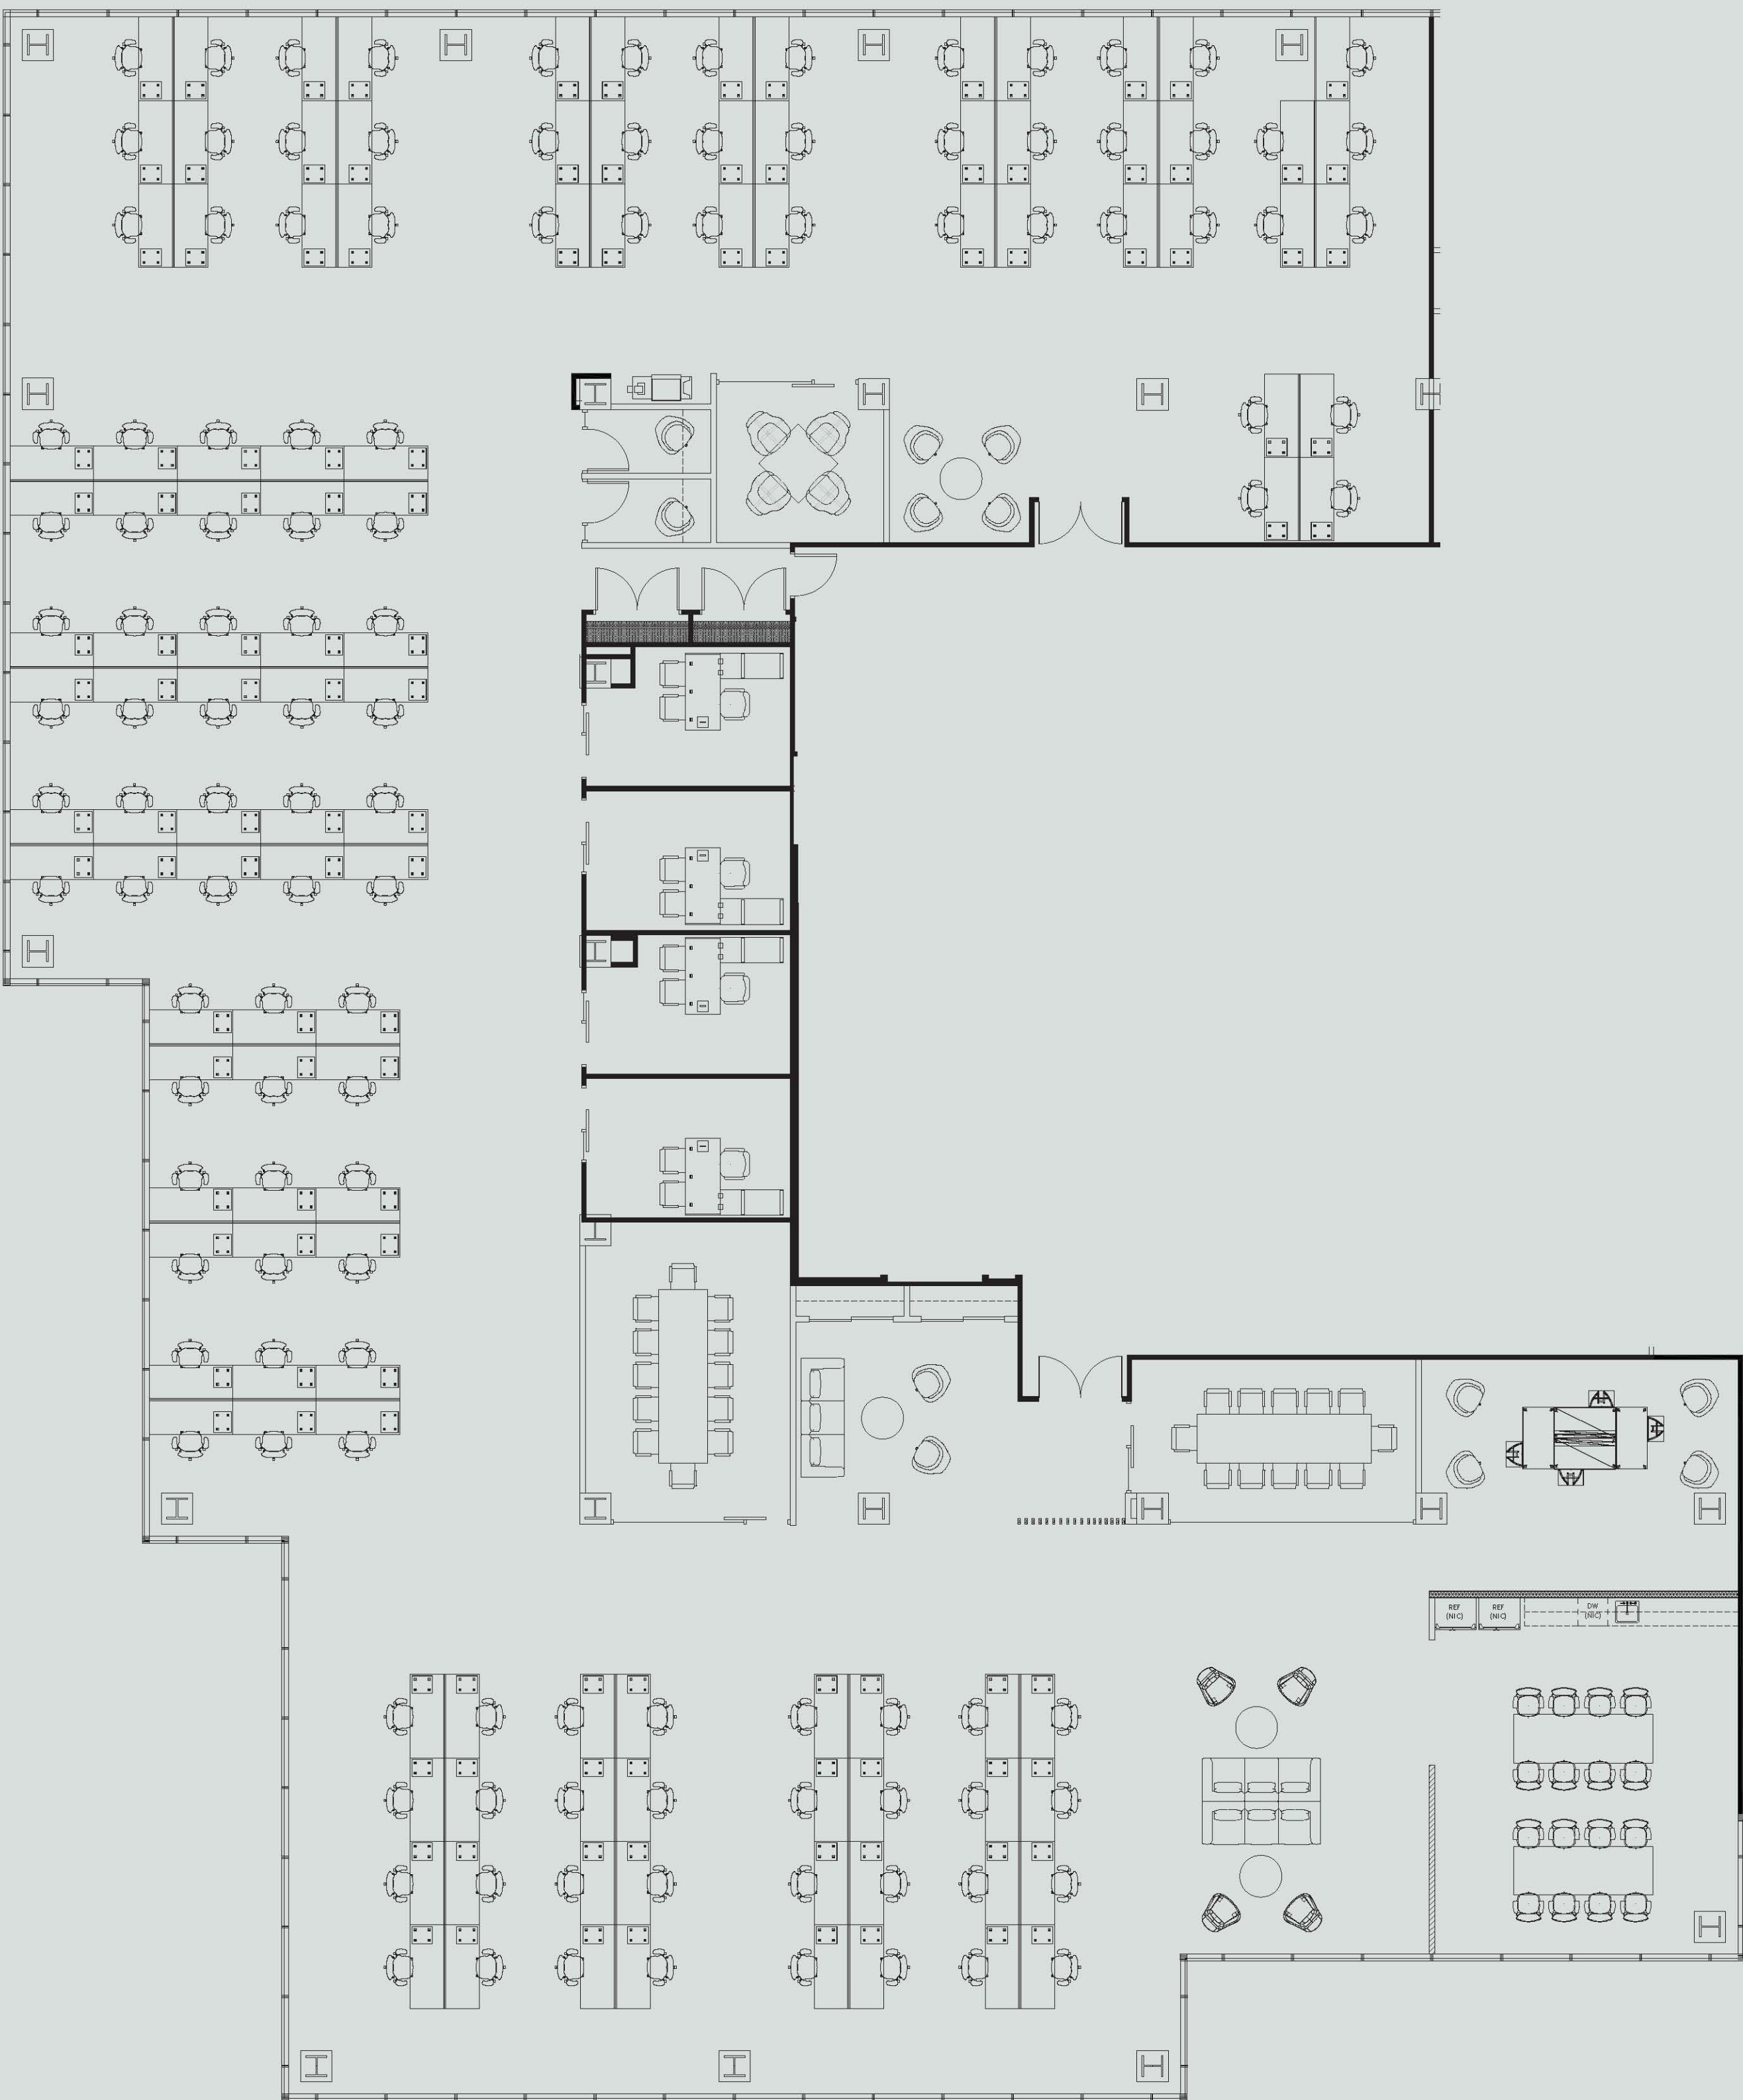

For leasing information please contact:
Mark J. Gunderson
312.448.8645
mark.gunderson@streamrealty.com

Ben Cleveland
312.448.6221
ben.cleveland@streamrealty.com