


6/4/2019 1:48:51 PM

A

B

C

D

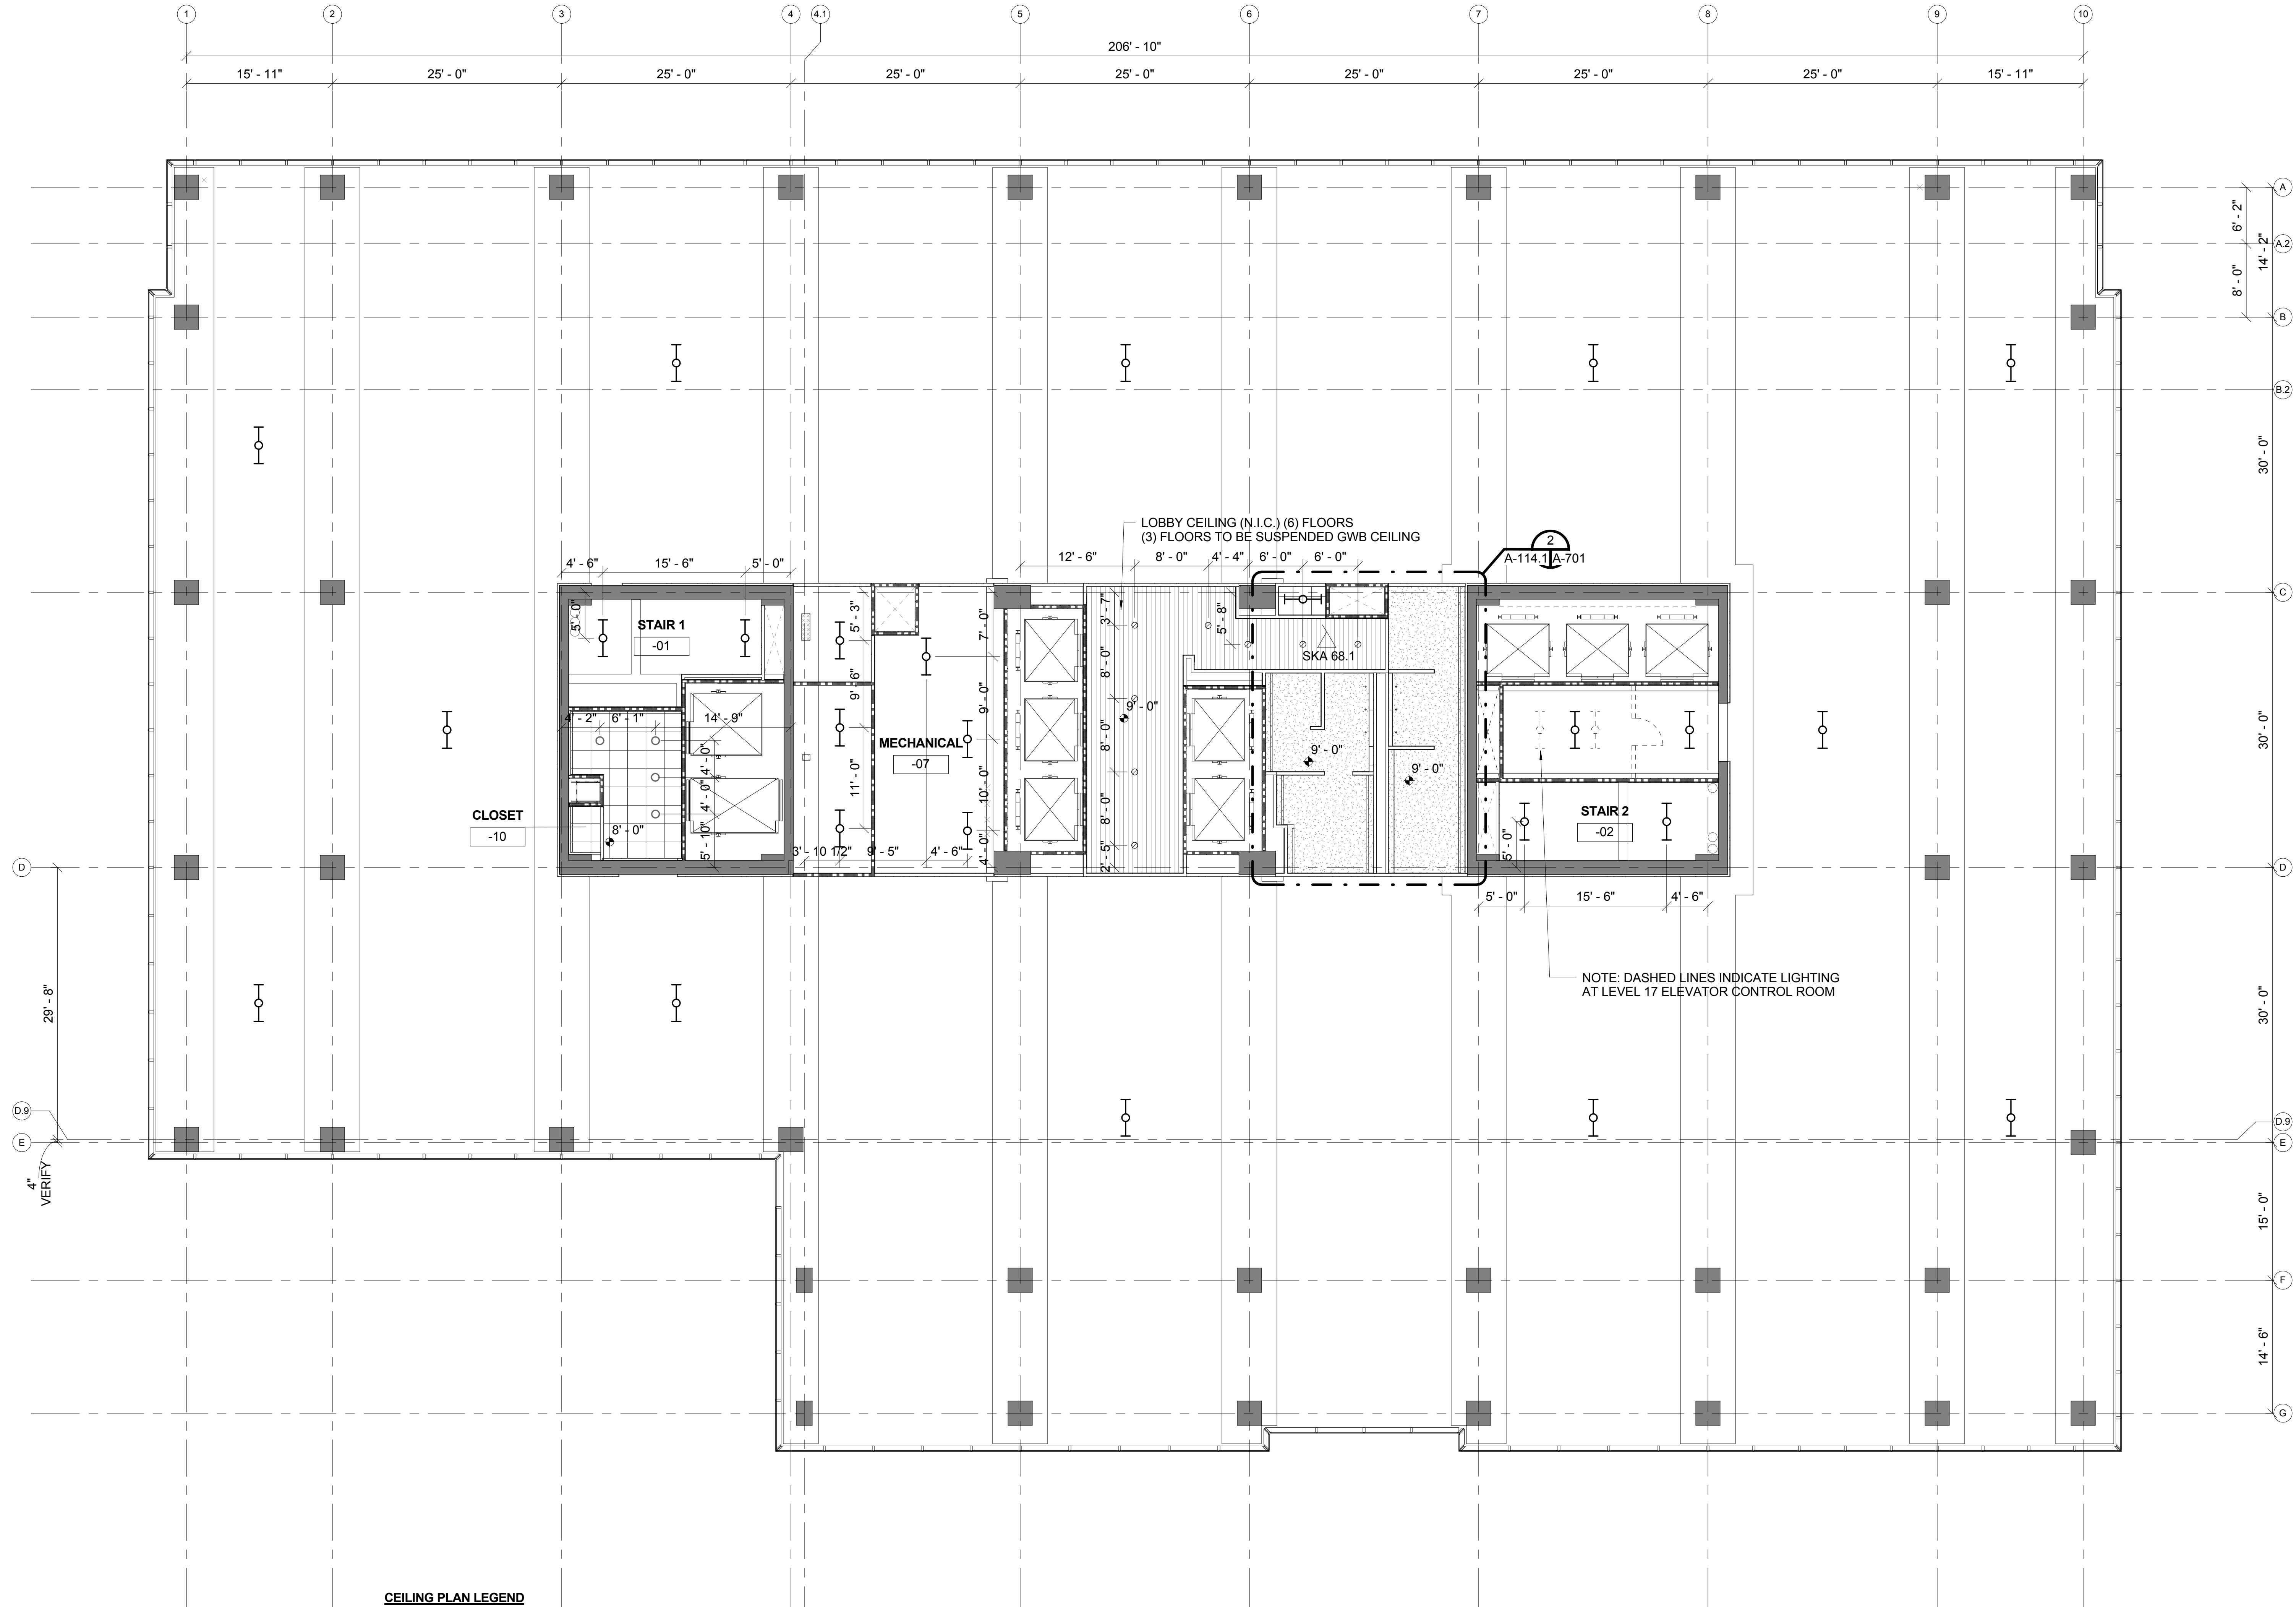

CEILING PLAN LEGEND

- 2X2 SUSPENDED ACOUSTICAL CEILING TILE
- SUSPENDED GWB CEILING
- UNDER SLAB INSULATION

NOTE: POST INSTALLED EXPANSION ANCHORS NOT ALLOWED IN POST TENSIONED SLABS

1 LEVEL 09
A-201/A-114.1/8" = 1'-0"



Mirecourt Associates, LLC

URS | AECOM

2020 K ST. NW, STE 300
WASHINGTON, DC 20006

SEALS

PROFESSIONAL CERTIFICATION I CERTIFY THAT THESE DOCUMENTS WERE PREPARED OR APPROVED BY ME, AND THAT I AM A DULY LICENSED PROFESSIONAL ARCHITECT UNDER THE LAWS OF THE STATE OF MARYLAND. LICENSE NUMBER 18789, EXPIRATION DATE 10-05-2020.

One Light Street
Baltimore, Maryland

PROJECT ISSUE DATES

DATE	DESCRIPTION
03/01/2017	ISSUED FOR CONSTRUCTION
03/08/2018	SKA 68.1 - RFI 242 OFFICE JAN CLO
06/08/2018	BULLETIN #2 - CONFORMED SET
05/31/2019	RECORD DRAWINGS

DRAWN BY
WDC

CHECKED BY
DM

DESIGNER
GB

URS PROJECT NO.
31945141

REFLECTED
CEILING PLAN -
LEVEL 09-17 -
OFFICE
A-114.1