


1 FUTURE FLOOR PLAN
1/8" = 1'-0"

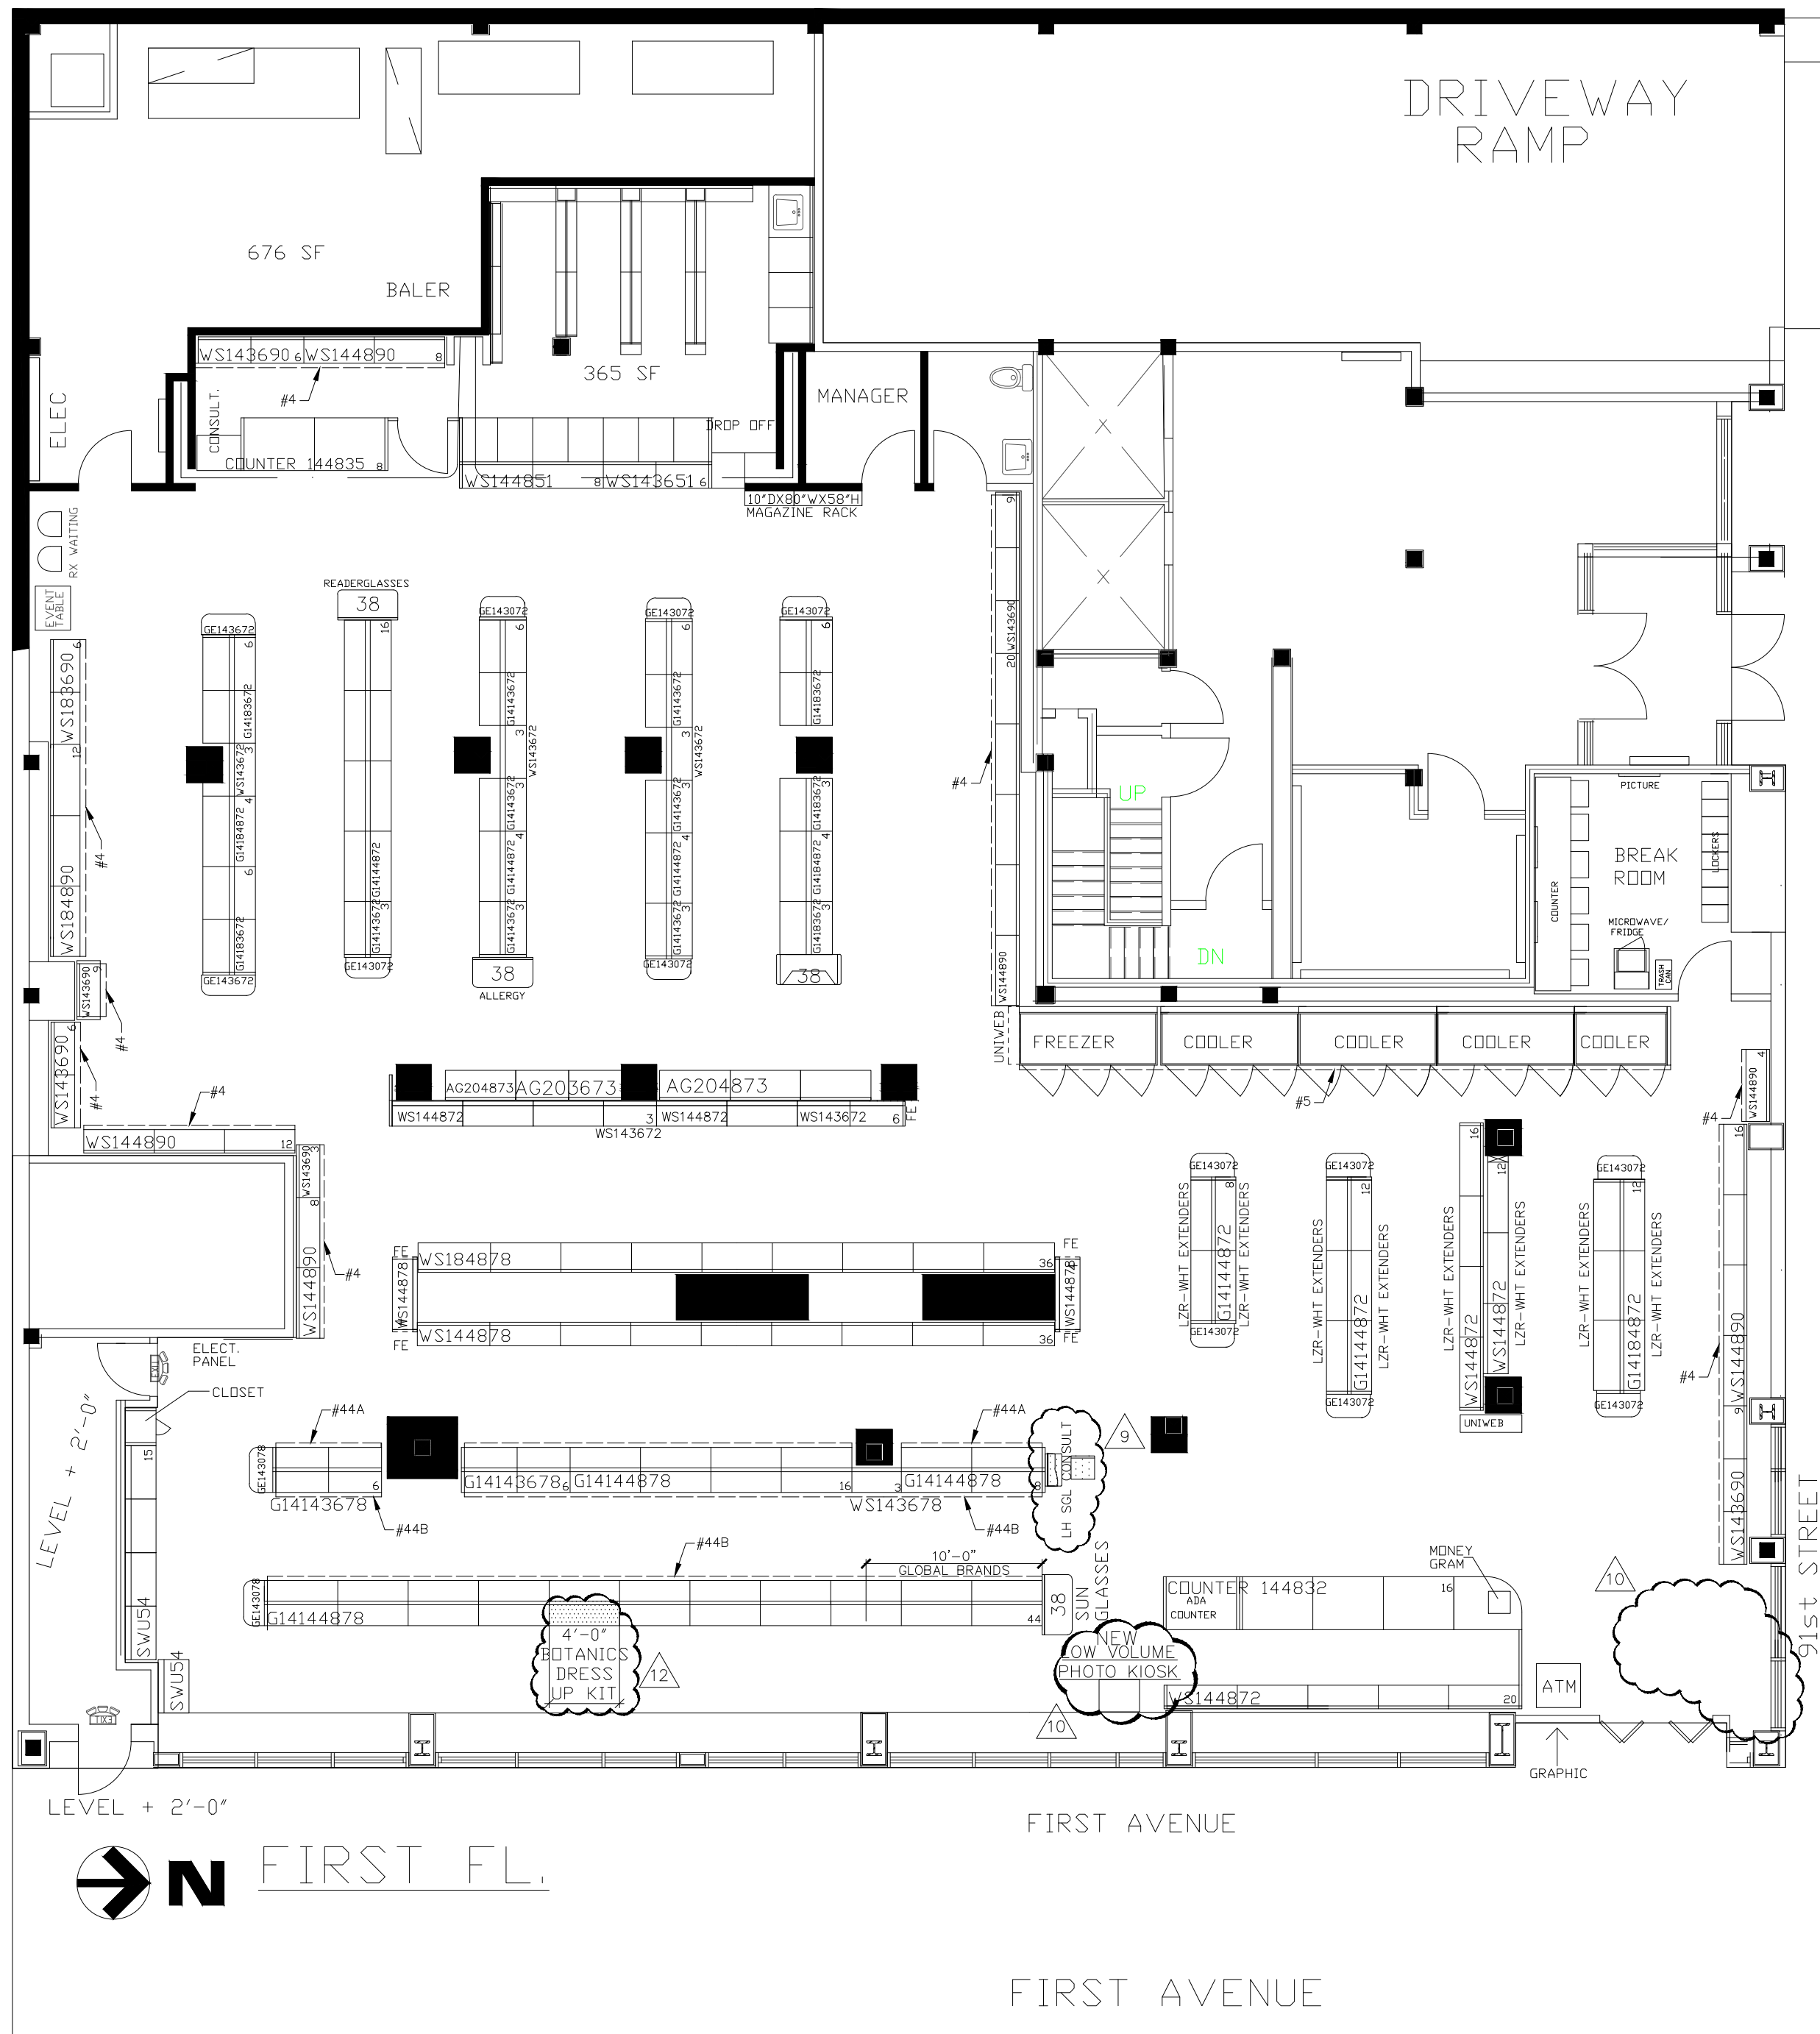

GENERAL NOTES

GENERAL SALES AREA:
1. PLEASE PROVIDE PROPER A.D.A. CLEARANCES ON BOTH SIDES OF ALL DOORS
2. (NOT USED)
3. (NOT USED)
4. SALES AREA CORNICE (FIXTURE MOUNTED)
5. DR MARKET CORNICE
6. CARPET TILES & ENTRY GRID FURNISHED AND INSTALLED BY WALGREENS
7. REACH-IN REFRIGERATION:
HILL PHOENIX REACH-IN OPEN CASE COOLERS (PROVIDE 2" AIR SPACE BEHIND & ADD 3" TO TOTAL LENGTH FOR END PANELS):
A. ___ OSMH-NRG 4': 48"W X 43 1/4"D X 88 5/8"H
___ OSMH-NRG 5': 72"W X 43 1/4"D X 88 5/8"H
___ OSMH-NRG 6': 96"W X 43 1/4"D X 88 5/8"H
HILL PHOENIX REACH-IN GLASS DOOR COOLERS (PROVIDE 2" AIR SPACE BEHIND & ADD 3" TO TOTAL LENGTH FOR END PANELS):
B. ___ ORBH 2-DR: 60"W X 42 1/16"D X 88 5/16"H
___ ORBH 3-DR: 90"W X 42 1/16"D X 88 5/16"H
___ ORBH 4-DR: 120"W X 42 1/16"D X 88 5/16"H
___ ORBH 5-DR: 150"W X 42 1/16"D X 88 5/16"H
___ ORBH 6-DR: 180"W X 42 1/16"D X 88 5/16"H

7. REACH-IN REFRIGERATION CONT'D:
HILL PHOENIX REACH-IN GLASS DOOR FREEZERS (PROVIDE 2" AIR SPACE BEHIND & ADD 3" TO TOTAL LENGTH FOR END PANELS):
C. ___ 6RZLH 2-DR: 60"W X 43 1/4"D X 87 1/8"H
___ 6RZLH 3-DR: 90"W X 43 1/4"D X 87 1/8"H
___ 6RZLH 4-DR: 120"W X 43 1/4"D X 87 1/8"H
___ 6RZLH 5-DR: 150"W X 43 1/4"D X 87 1/8"H
HILL PHOENIX / BARKER PENINSULA COOLERS:
D. ___ PFI-507-62R: 85"W X 60"D X 63"H
___ PFI-509-62R: 109"W X 60"D X 63"H
___ PFI-512-62R: 145"W X 60"D X 63"H
HILL PHOENIX / BARKER ISLAND COOLERS:
E. ___ PFI-509-62R: 96 1/2"W X 60 3/4"D X 62"H
___ PFI-511-62R: 132 7/8"W X 60 3/4"D X 62"H
___ PFI-515-62R: 180 1/2"W X 60 3/4"D X 62"H
DOUBLE SIDED SLIDING GLASS DOOR COOLER
L. ___ TRUE GDM-41CPT-48: 48"W X 24 1/2"D X 48"H
MASTER-BILT BACK-UP REACH-IN COOLERS:
M. ___ MBR23-S 1-DR: 27 1/2"W X 31 1/4"D X 83 3/4"H
___ MBR49-S 2-DR: 55 1/4"W X 31 1/4"D X 83 3/4"H
___ MBR72-S 3-DR: 78"W X 31 1/4"D X 83 3/4"H
MASTER-BILT BACK-UP REACH-IN FREEZERS:
N. ___ MBF23-S 1-DR: 27 1/2"W X 31 1/4"D X 83 3/4"H
___ MBF49-S 2-DR: 55 1/4"W X 31 1/4"D X 83 3/4"H
___ MBF72-S 3-DR: 78"W X 31 1/4"D X 83 3/4"H

8. MASTER-BILT WALK-IN COOLER:
___ 1000R COOLMASTER DOORS
30" X 75" EACH AND
___ 100FR FREEZEMASTER DOORS
30" X 75" EACH BY ANTHONY
A. DOOR(S): FOR EACH DOOR PROVIDE 4"D DISPLAY PLAN DEEP ROLLER MAT SHELVES
B. DOOR(S): FOR EACH DOOR PROVIDE 3"D DISPLAY PLAN ROLLER MAT SHELVES
C. DOOR(S): 1" D ROLLER CONVEYOR AT FLOOR LEVEL
D. DOOR(S): FOR EACH DOOR PROVIDE 27"D ANTHONY SHELVES
E. DOOR(S): FOR EACH DOOR PROVIDE (2) 27"D ANTHONY SHELVES AND (4) 36"D MERCHANDISER SHELVES
F. DOOR(S): 1" D DOUBLE DECK ROLLER CONVEYOR
9. ICE CHEST BY VENDOR
10. CART RAILS: () RL3635 & () RL3035
11. PROVIDE A 6TH JOHNSONITE - CHARCOAL VINYL BASE AT ALL CHECKOUTS,
EXCEPT BEAUTY CHECKOUT
12. ELECTRONIC ARTICLE SURVEILLANCE SYSTEM

PHARMACY DEPARTMENT:
13. TRAFFIC CONTROL FIXTURE
A. STANDARD
B. HIGH VOLUME
C. HIGH VOLUME (SMALL)
D. HIGH VOLUME (SMALL)
E. CUSTOM
14. (NOT USED)
15. COMPUTER TERMINAL
15A. INTERCOM PLUS TERMINAL
15C. TRAINING TERMINAL (IN OFFICE)
16. RX SINK AND CABINET
A: PHARMACY
B: CONSULT ROOM
17. CRX CABINET
18. RX REFRIGERATOR
A: 1-DR REFRIGERATOR (19 CU. FT.)
B: 1-DR REFRIGERATOR (26 CU. FT.)
C: 2-DR REFRIGERATOR (49 CU. FT.)
D. UNDER COUNTER REFRIGERATOR
E: COUNTERTOP FREEZER
19. PROVIDE RUBBER TILE FLOOR
RX UNDERCOUNTER INSERTS:
#1- RX 3 DRAWER VIAL INSERT
#2- RX 3 DRAWER FILE INSERT
#3- RX OPEN INSERT
#4- RX CONSULTATION COUNTER UNIT
#5- RX PRINTER INSERT

RX UNDERCOUNTER INSERTS CONT'D:
#6- RX 5 DRAWER FILE INSERT
#7- RX OPEN INSERT WITH CPU SHELF (39"H)
#8- RX OPEN INSERT WITH CPU SHELF (34"H)
#9- RX OPEN CABINET (39"H CNTR)
#10- RX 10 DRAWER FILE CABINET
OFFICE:
20. PROVIDE POLISHED CONCRETE FLOOR & VINYL WALLCOVERING
21. UNDER COUNTER SHELF UNIT
22. PRINTER
23. LATERAL FILE
24. OFFICE COMPUTERS
24A: P.O.S. TERMINAL
24B: AS400 TERMINAL
24C: OFFICE P.C.
25. TILL LOCKER
26. SAFE
27. (NOT USED)
28. NEST-A-FLEX CONVEYOR
28A: 28"-44"H ADJUSTABLE LEGS
28B: 36"-52"H ADJUSTABLE LEGS
29. GRAVITY CONVEYOR
30. POWER ROLLER CONVEYOR
31. SEE ARCHITECTURAL DRAWINGS FOR EXACT LOCATION & POSITIONING OF COMPACTORS
31A: TRASH COMPACTOR
31B: BALER
31C: CARDBOARD COMPACTOR

EMPLOYEE ROOM:
32. EMPLOYEE DIGI LOCKERS:
A: STANDARD SET WITH COAT ROD
B: FLAGSHIP SET WITH COAT RODS
33. - "W X 0-00 EMPLOYEE COUNTER W/ (1) CABINET
34. EMPLOYEE ROOM REFRIGERATOR (PROVIDE 32" CLEARANCE WHEN NEXT TO COUNTER)
35. EMPLOYEE ROOM SINK (IN COUNTER)
36. (NOT USED)
37. "E" - ELECTRICAL OUTLET FOR FUTURE USE
38. VENDOR RACKS: REMOVE BASE DECK & SHOES; (END PANEL TO REMAIN)
39. (NOT USED)
40. NEWSPAPER RACK BY VENDOR
41. PICTURE CARE PLUS TERMINAL
42. SKIN CARE & DIABETES LIT HEADER
43. (NOT USED)
44A. LIT COSMETICS HEADER (FLAGSHIP, ASCEND & DUANE READE STORES ONLY)
44B. LIT COSMETICS HEADER WITH LIT OUTRIGGER
45. LIT GONDOLA END PANEL & FROSTED SHELVES
46. SOLID WHITE BACK PANEL TO BE PROVIDED BY METAL VENDOR
47. NON-LIT HEADER WITH LIT OUTRIGGER
48. LIT OUTRIGGER ONLY
49. SIGN CHANNEL ONLY
50. COTTON END SIGN CHANNEL
51. IMG
52. WOOD WRAPAROUND COSMETIC HEADER
57. COSMETIC END CAP HEADER

FURNITURE LEGEND			PROJECT DATA									
A1.1	GUEST CHAIR	0	TYPE	GENERAL SALES		MARKET						
A3.1	SIDE CHAIR	0	NEW LOCATION	☐	PHARMACY		☒ SECURITY		☐			
A4.2	TASK STOOL	0	NEW LOCATION EXIST'G BLDG	☐	PHOTO		☐ 24 HOUR STORE		☐			
A5.1	TASK CHAIR (OFFICE)	0	REMODEL	☒ LIQUOR		☐ OTHER		☐				
A5.2	TASK STOOL (OFFICE)	0	SQAURE FOOT AREA SUMMARY									
A6	GUEST STOOL	0	DEPARTMENT	SALES	STOCK	SERVICE	TOTAL EXIST'G	TOTAL NEW				
B1.1	COFFEE TABLE - 24" X 48"	0	GEN SALES	NEW	4721	755	1977	7453				
B1.2	SIDE TABLE - 24" X 24"	0	EXIST'G	4721	755	1977	7453					
B2	EMPLOYEE ROOM TABLE	0	MARKET	NEW	900			900				
B3.2	WORKTABLE - 27" X 36"	0	EXIST'G	900			900					
HEALTHCARE CLINIC LEGEND			RX	NEW	493		0	493				
D1	EXAM TABLE	0	EXIST'G	493		0	493					
Q	SCALE	0	RX WAIT'G	NEW	62			62				
R	HUTCH W/ UNDER COUNTER REFRIGERATOR	0	EXIST'G	62			62					
S	COAT CLOSET W/ 2 FILE DRAWERS	0	PHOTO	NEW	0			0				
U1	MEDICAL HUTCH W/ EMP. HAND SINK LEFT	0	EXIST'G	0			0					
U2	MEDICAL HUTCH W/ EMP. HAND SINK RIGHT	0	BEER& WINE	NEW	0	0	0	0				
W1	WORKSTATION W/MONITOR ON LEFT	0	EXIST'G	0	0	0	0	0				
W2	WORKSTATION W/MONITOR ON RIGHT	0	CLINIC	NEW	0			0				
X	36"X36"X12" DIAGNOSTIC CABINET	0	EXIST'G	0				0				
METAL VENDOR & COLOR			LOOK BOUTIQUE	NEW	0	0	0	0				
PRIMARY	OSF, BEIGE, ASSUME ALL SHELVING FALLS INTO THIS CATEGORY UNLESS NOTED ON D111	0	EXIST'G	0	0	0	0	0				
			NEW	0	0	0	0	0				
EXTENSIONS	LOZIER, WHITE, NOTED ON D111/REFER TO PLAN	0	BSMT	EXIST'G	0	0	0	0				
METAL VENDOR KEY			2ND FLOOR	NEW	0	0	0	0				
ABBR.	VENDOR	NOTCH	EXIST'G	0	0	0	0	0				
			TOTAL NEW	0	0	0	0	0				
LZR	LOZIER	1"	TOTAL EXST'G	0	0	0	0	0				
MDX	MADIX	1"	TOTAL AREA: FIRST FLOOR						8,908 SQ.FT.			
HCK	HUCK	1"	TOTAL AREA: OTHER LEVELS						0 SQ.FT.			
HCK-2	HUCK	1.75"	GROSS AREA INCLUDING ALL DEPARTMENTS & ALL LEVELS:						8,908 SQ.FT.			
KLR	KIECHLER	1"	RX SHELVING LINEAL FEET:						67 LN.FT.			
KLR-2	M	1.75"										
OSF	OSF	1"										
PS	PERMA-STEEL	1BD										
STR	STREETER	1.25"										
LAD	LA DARLING	1BD										
BDE FURNITURE LEGEND			SUMMARY OF CHANGES									
A7	GUEST STOOL - NEW	1	LINEAL FOOTAGE									
			EXISTING				PROPOSED		CHANGE			
			TOTAL LINEAL FOOTAGE (NOT INCLUDING LOZIER STORE)				763 In ft		763 In ft			
			SHELVING				705 In ft		705 In ft			
			GREETING CARDS				22 In ft		22 In ft			
			SEASONAL				0 In ft		0 In ft			
			COOLERS				29 In ft		29 In ft			
			FREEZERS				7 In ft		7 In ft			
			PHARMACY LINEAL FOOTAGE				67 In ft		67 In ft			
			PROMO FOOTAGE									
			EXISTING				PROPOSED		CHANGE			
			END STAND QTY				20		20			
			SIDE PANEL QTY				0		0			
			TABLE QTY				0		0			
			QUEUEING				0		0			
			BEAUTY				0		0			
			SQUARE FOOTAGE									
			EXISTING				PROPOSED		CHANGE			
			BUILDING SQ. FT.				8,908 sq ft		8,908 sq ft			
			STOCK SQ. FT.				755 sq ft		755 sq ft			
			RX INTERIOR SQ. FT.				493 sq ft		493 sq ft			
			HEALTHCARE SQ. FT.				555 sq ft		555 sq ft			
			DAILY LIVING SQ. FT.				4,721 sq ft		4,721 sq ft			
			REMODEL & HATCH LEGEND									
			EXISTING				NEW					
			RESET									
			FIXTURE LEGEND									
			G GONDOLA (EA. SIDE)					ALL OTHER FIXTURES ARE TYPICALLY CALLED OUT DEPTH BY WIDTH.				
			GE GONDOLA END					EXAMPLE: DT DISPLAY TABLE				
			WS WALL SHLVG					30 48 D. W.				
			*DOES NOT INCLUDE STANDARDS, WOOD GROUNDS OR FINISHED END PANELS									
			FIXTURE COLOR LEGEND									
			WT WHITE									
			PT PUTTY									
			AB ARCHITECTURAL BRONZE									
			TP TAUPE									
			GM GUNMETAL GREY									
			SR SILVER									
			BUSINESS OWNER APPROVAL							DATE		
			DAILY LIVING				F. LASTNAME			XX/XX/XX		
			PHARMACY SERVICES				F. LASTNAME			XX/XX/XX		
			BRANDING				F. LASTNAME			XX/XX/XX		
			STORE OPERATIONS				F. LASTNAME			XX/XX/XX		
			REGIONAL DESIGN PARTNER				F. LASTNAME			XX/XX/XX		
			STORE PLANNER				M.GREEN			05/19/17		
			*ACCESSIBILITY REQUIREMENTS MAY VARY WITH LOCAL JURISDICTIONS & APPROACH TO DOOR SWING									

DUANE READE
MERCANDISING - STORES PLANNING
440 9TH AVENUE
NEW YORK, NY 10011

THIS DOCUMENT IS THE PROPERTY OF DUANE READE. IT IS TO BE USED FOR THE PROJECT SPECIFIED ONLY. IT IS NOT TO BE REPRODUCED OR TRANSMITTED IN ANY FORM OR BY ANY MEANS, ELECTRONIC OR MECHANICAL, INCLUDING PHOTOCOPYING, RECORDING, OR BY ANY INFORMATION STORAGE AND RETRIEVAL SYSTEM, WITHOUT THE WRITTEN PERMISSION OF DUANE READE.

12 05/17/12 AA BDE 1262 D1/MD1 COORDINATION
11 12/20/16 VCN RELOCATED NEW LOW VOLUME PHOTO KIOSK PER
10 12/12/16 VCN ADDED NEW LOW VOLUME PHOTO KIOSK
9 11/01/16 SH BDE LAUNCH 2 GROUP 72-REFER TO SCOPE
8 10/25/16 VCN REVISED WALL SHELVING BY GREETING CARDS PER
7 06/31/16 VCN REPLACE TOBERRY KIOSK WITH NEW STANDARD
MATCH FIELD: ADD EXTO UNDER BACK IN AND
REVISE REMOVED BASE DECKS TO REMAIN.

6 06/01/16 KS REVISED (3) NEW 38" TUBERAYS TO EXT'G
5 07/04/16 KS VENDOR ENDSTANDS UPDATED TO ACCURATELY
4 05/02/16 DBA REPRESENT RESET AND/OR NEW PLACEMENT; METAL
SEE PREVIOUS D111 FOR PROG/OUTDATED REVISION
NOTES

PROJECT ID: NXXXX
STORE NUMBER: 14351
DUANE READE
1745 FIRST AVENUE
MANHATTAN, NEW YORK
BDE 1262

FILE NAME:
14351-D111-20-17MAX17
DRAWN BY:
AAGUDELO / WOLF
DATE: 12/06/12
REVIEWED:
M.GREEN

NO. DATE BY DESCRIPTION REVISIONS