



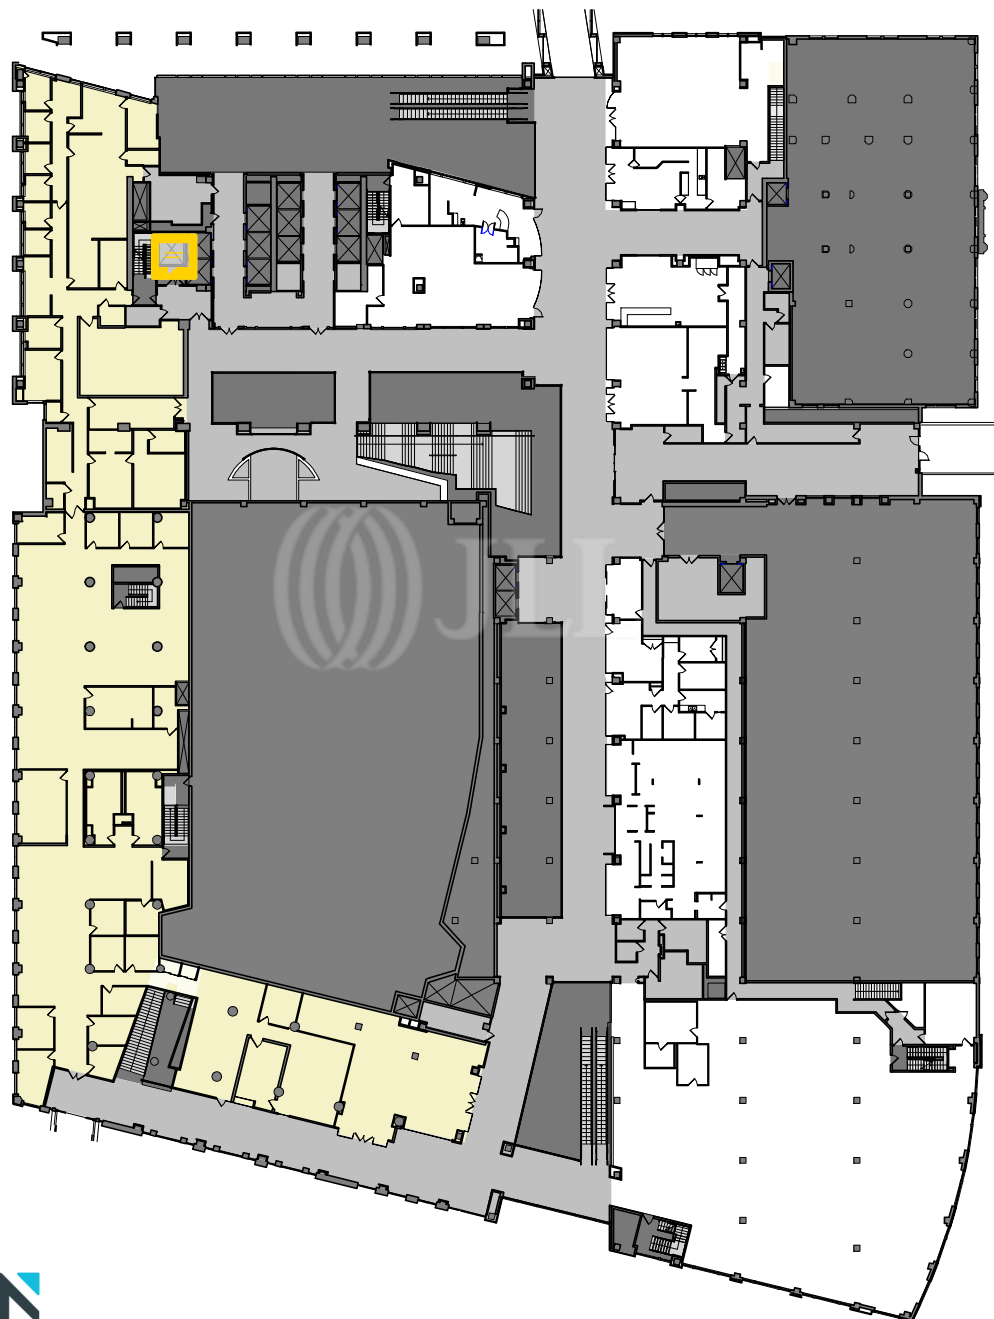

LASALLE PLAZA

Minneapolis, Minnesota

SECOND FLOOR - COMPOSITE AS-BUILT PLAN

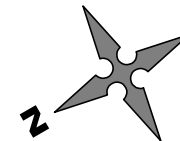

Zeller Realty Group®

NELSON

Issue Date: 04/28/2021