


SITUATIONSPLAN, 1:500



RELATIONSHANDLING
2018-07-03

BJÖRNEN 22 - MALMÖ
PLAN 1
SKALA 1:50 (A1)

new line
NEW LINE ARKITEKTER AB
SÖRRA FÖRSTADSGATAN 23 211 43 MALMÖ
TEL 040-30 00 30 www.newlineark.se

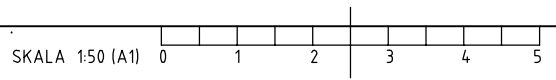

XREF:

LAGER: SB11

PLG: 2018-07-03 14:57 Z:\NL ARKIVET\PROJEKT NL 2851-13859 B BJÖRNEN 22 - RESTAURANG 7 RITNINGAR\7 RELATIONSHANDLING A-40-P-01DWG CAD2