

# 8<sup>th</sup> FLOOR · SUITE 812

## AS BUILT PLAN

RUSS BUILDING  
235 MONTGOMERY




[www.russbldg.com](http://www.russbldg.com)

Jim Collins  
415.352.7239

[jcollins@shorenstein.com](mailto:jcollins@shorenstein.com)  
CA RE 00860991

Tom McDonnell  
415.772.7086

[tmcdonnell@shorenstein.com](mailto:tmcdonnell@shorenstein.com)  
CA RE 01011145

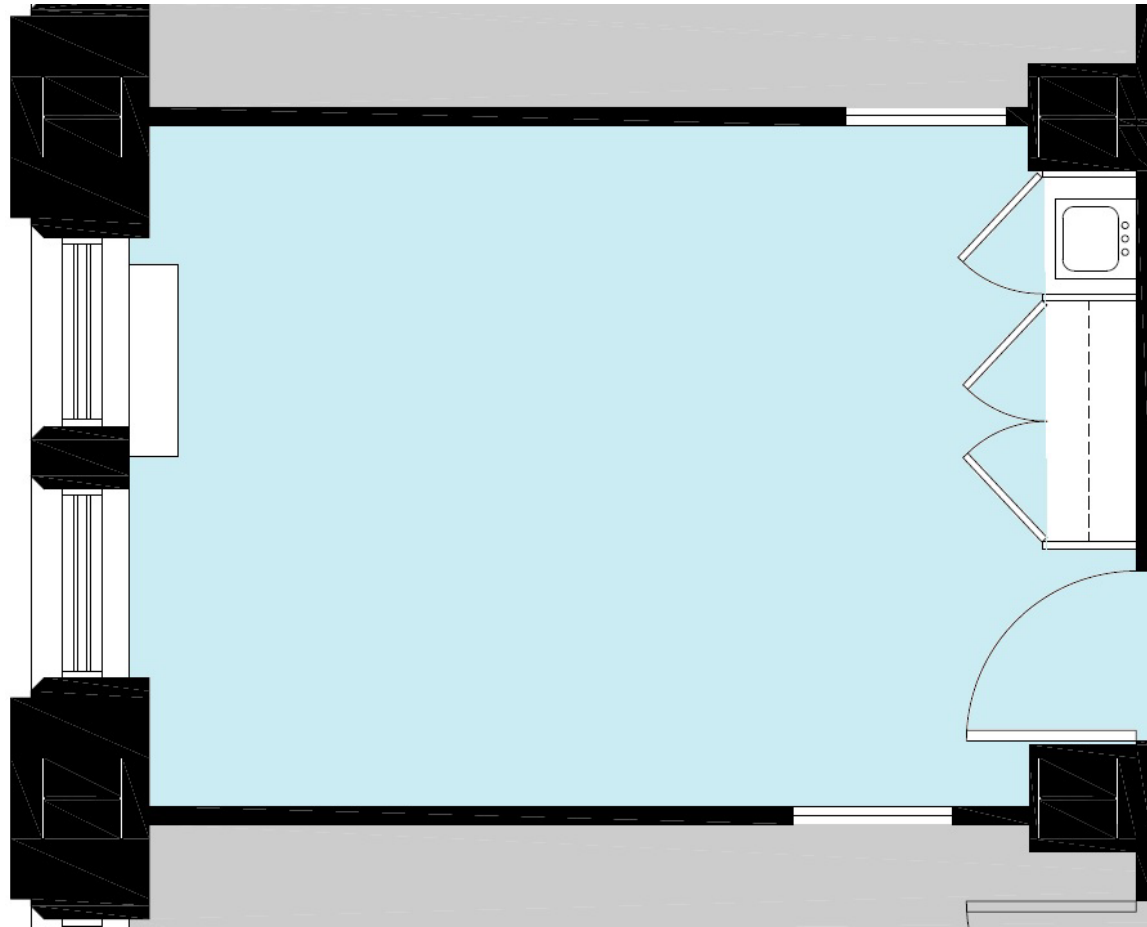

235 Montgomery St,  
San Francisco, CA 94104

**AVAILABLE · 367 RSF**  
**Boutique Window Line Office**  
**Perfect for Single Office Occupancy**  
**Sink and Storage Closet**

