


GENERAL NOTES:

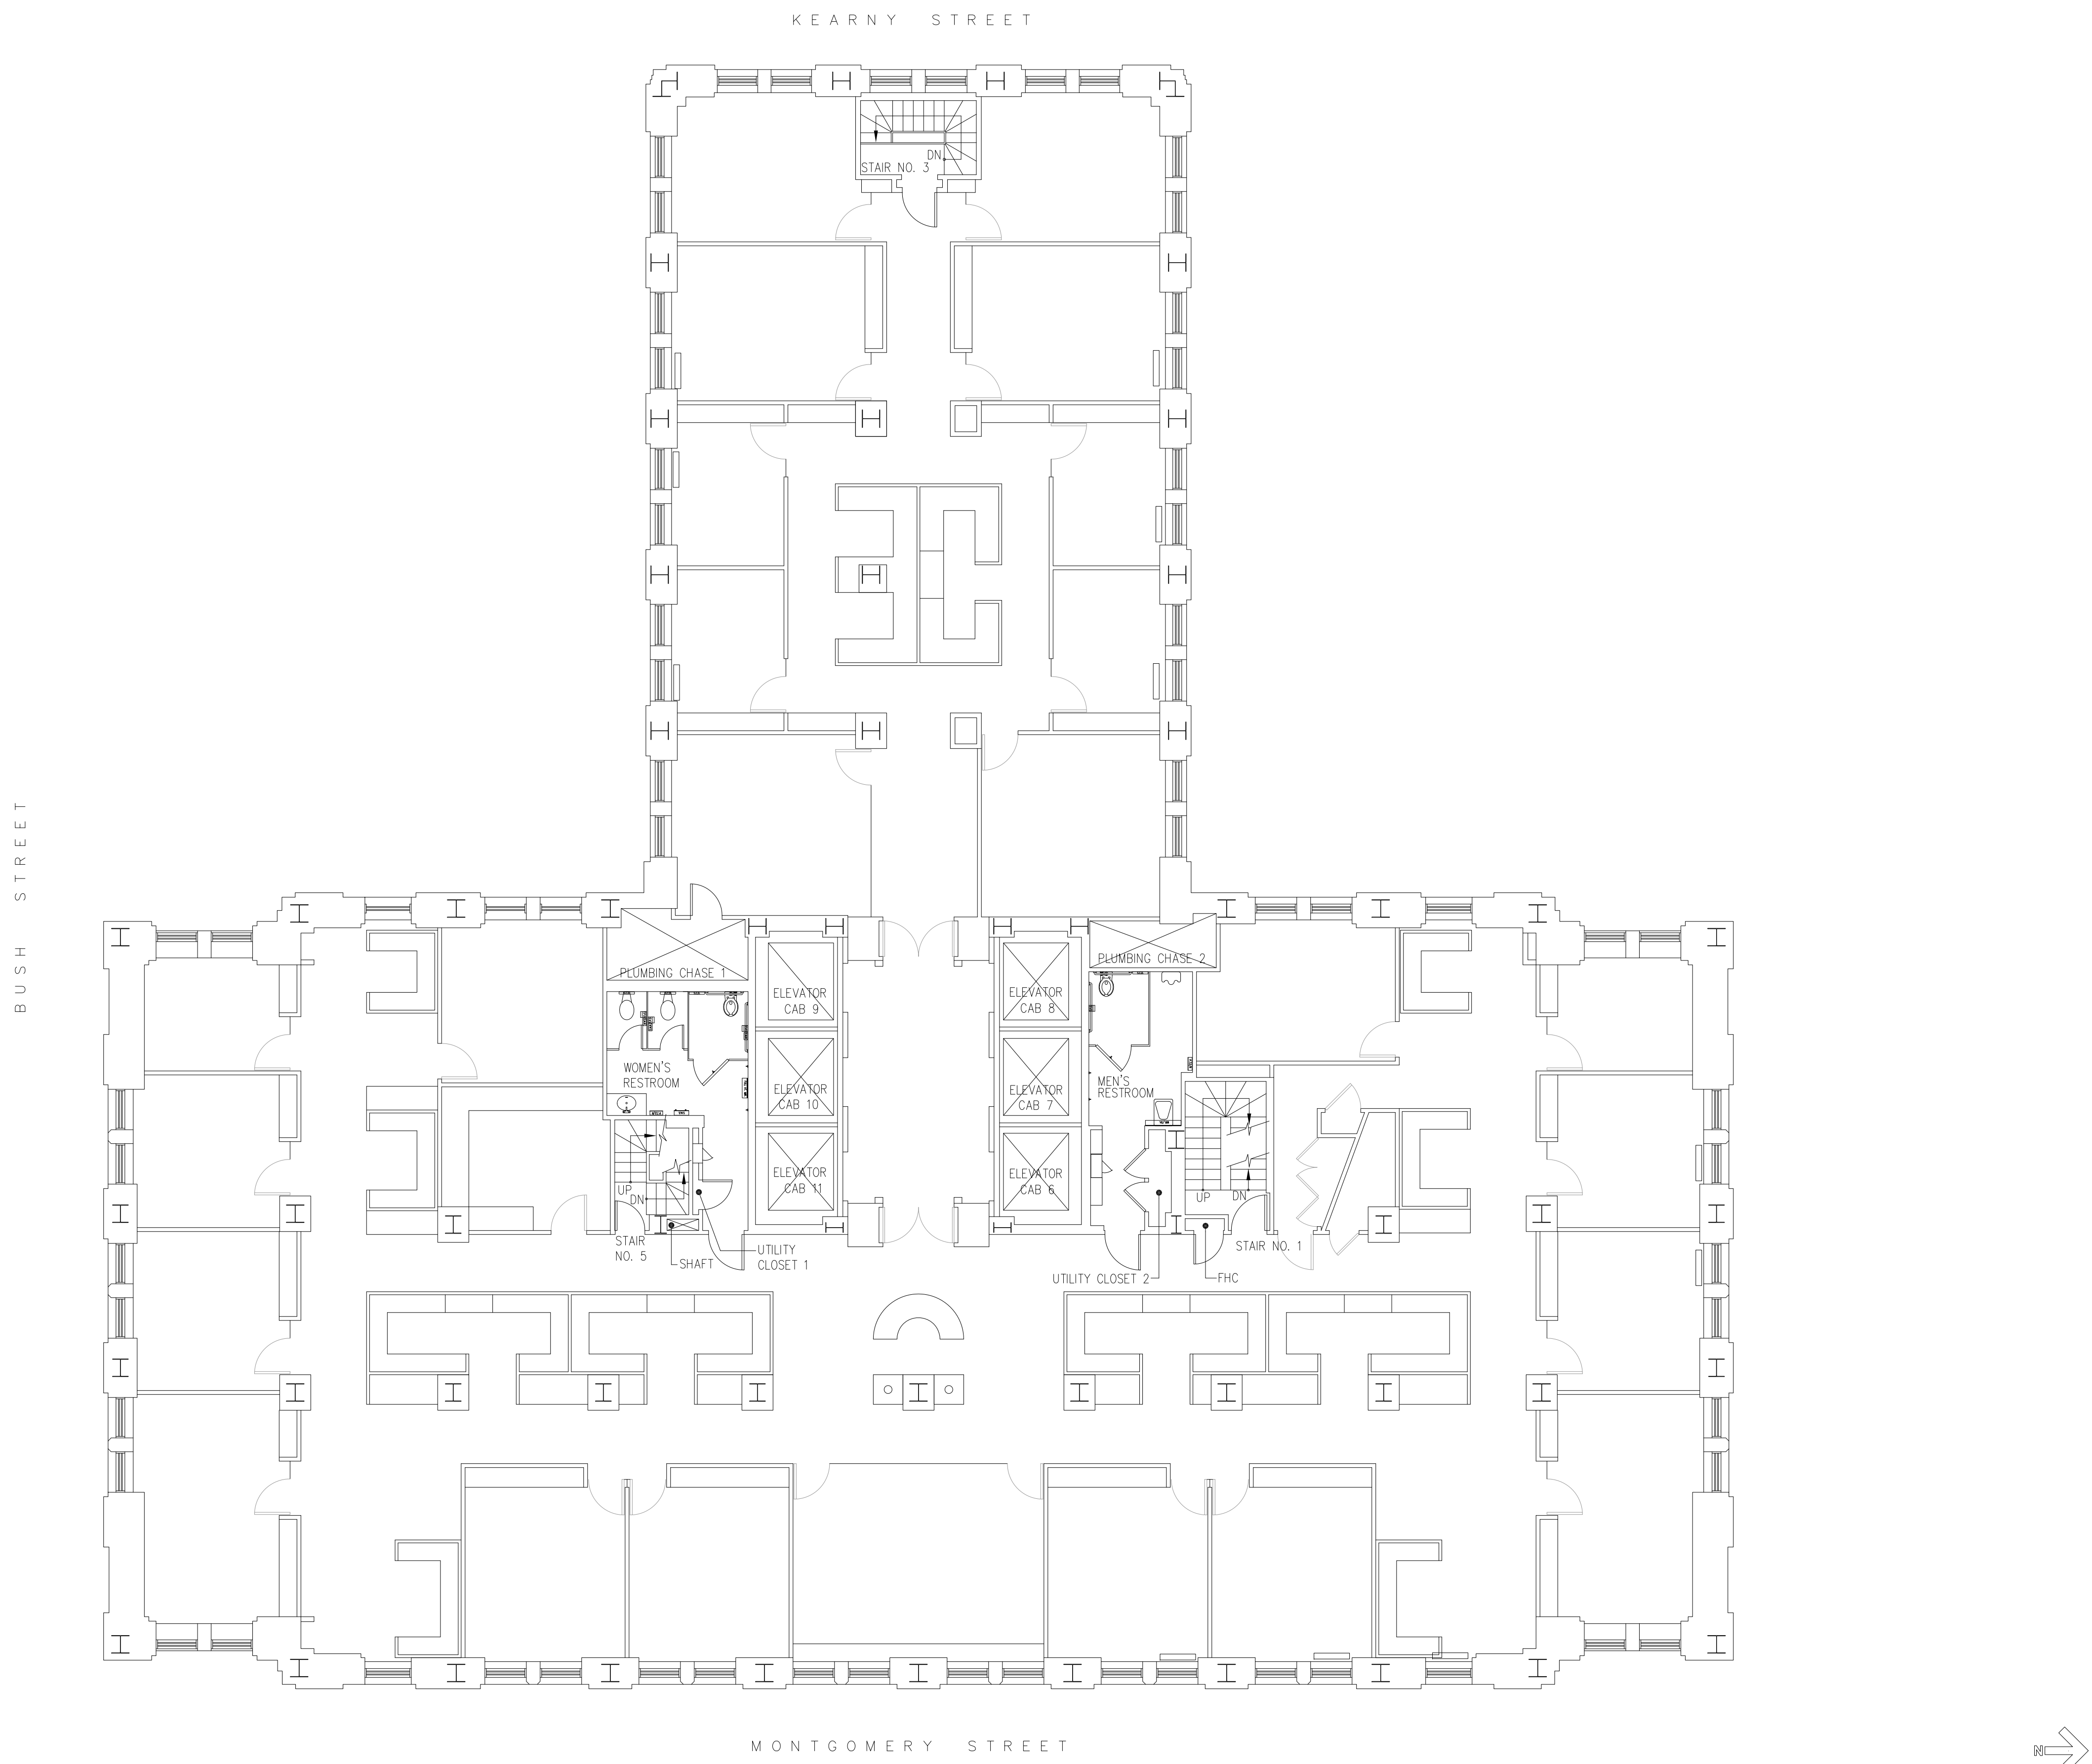


FIELD VERIFICATION OF ALL DIMENSIONS AND EXISTING CONDITIONS ARE THE RESPONSIBILITY OF ALL DESIGN AND/OR CONSTRUCTION PROFESSIONALS USING THESE DOCUMENTS. NO REPRESENTATION OF THE ACCURACY OF THESE DOCUMENTS IS PROVIDED.

SRS Archive	01/26/04
Restroom Retrofit Update	11/08/04
.	.
.	.
PROJECT NUMBER:  
BUILDING:  
**Russ Building**  
235 Montgomery St.  
San Francisco, CA

Suite 2200

AS BUILT PLAN  
FILE NAME:  
I\_227BMB.dwg

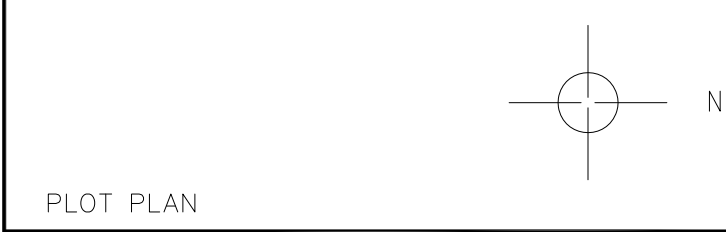

PLOT PLAN  
CONSULTANT

DRAWN BY: . . . . . SCALE: 1/8"=1'-0"