


GENERAL NOTES:

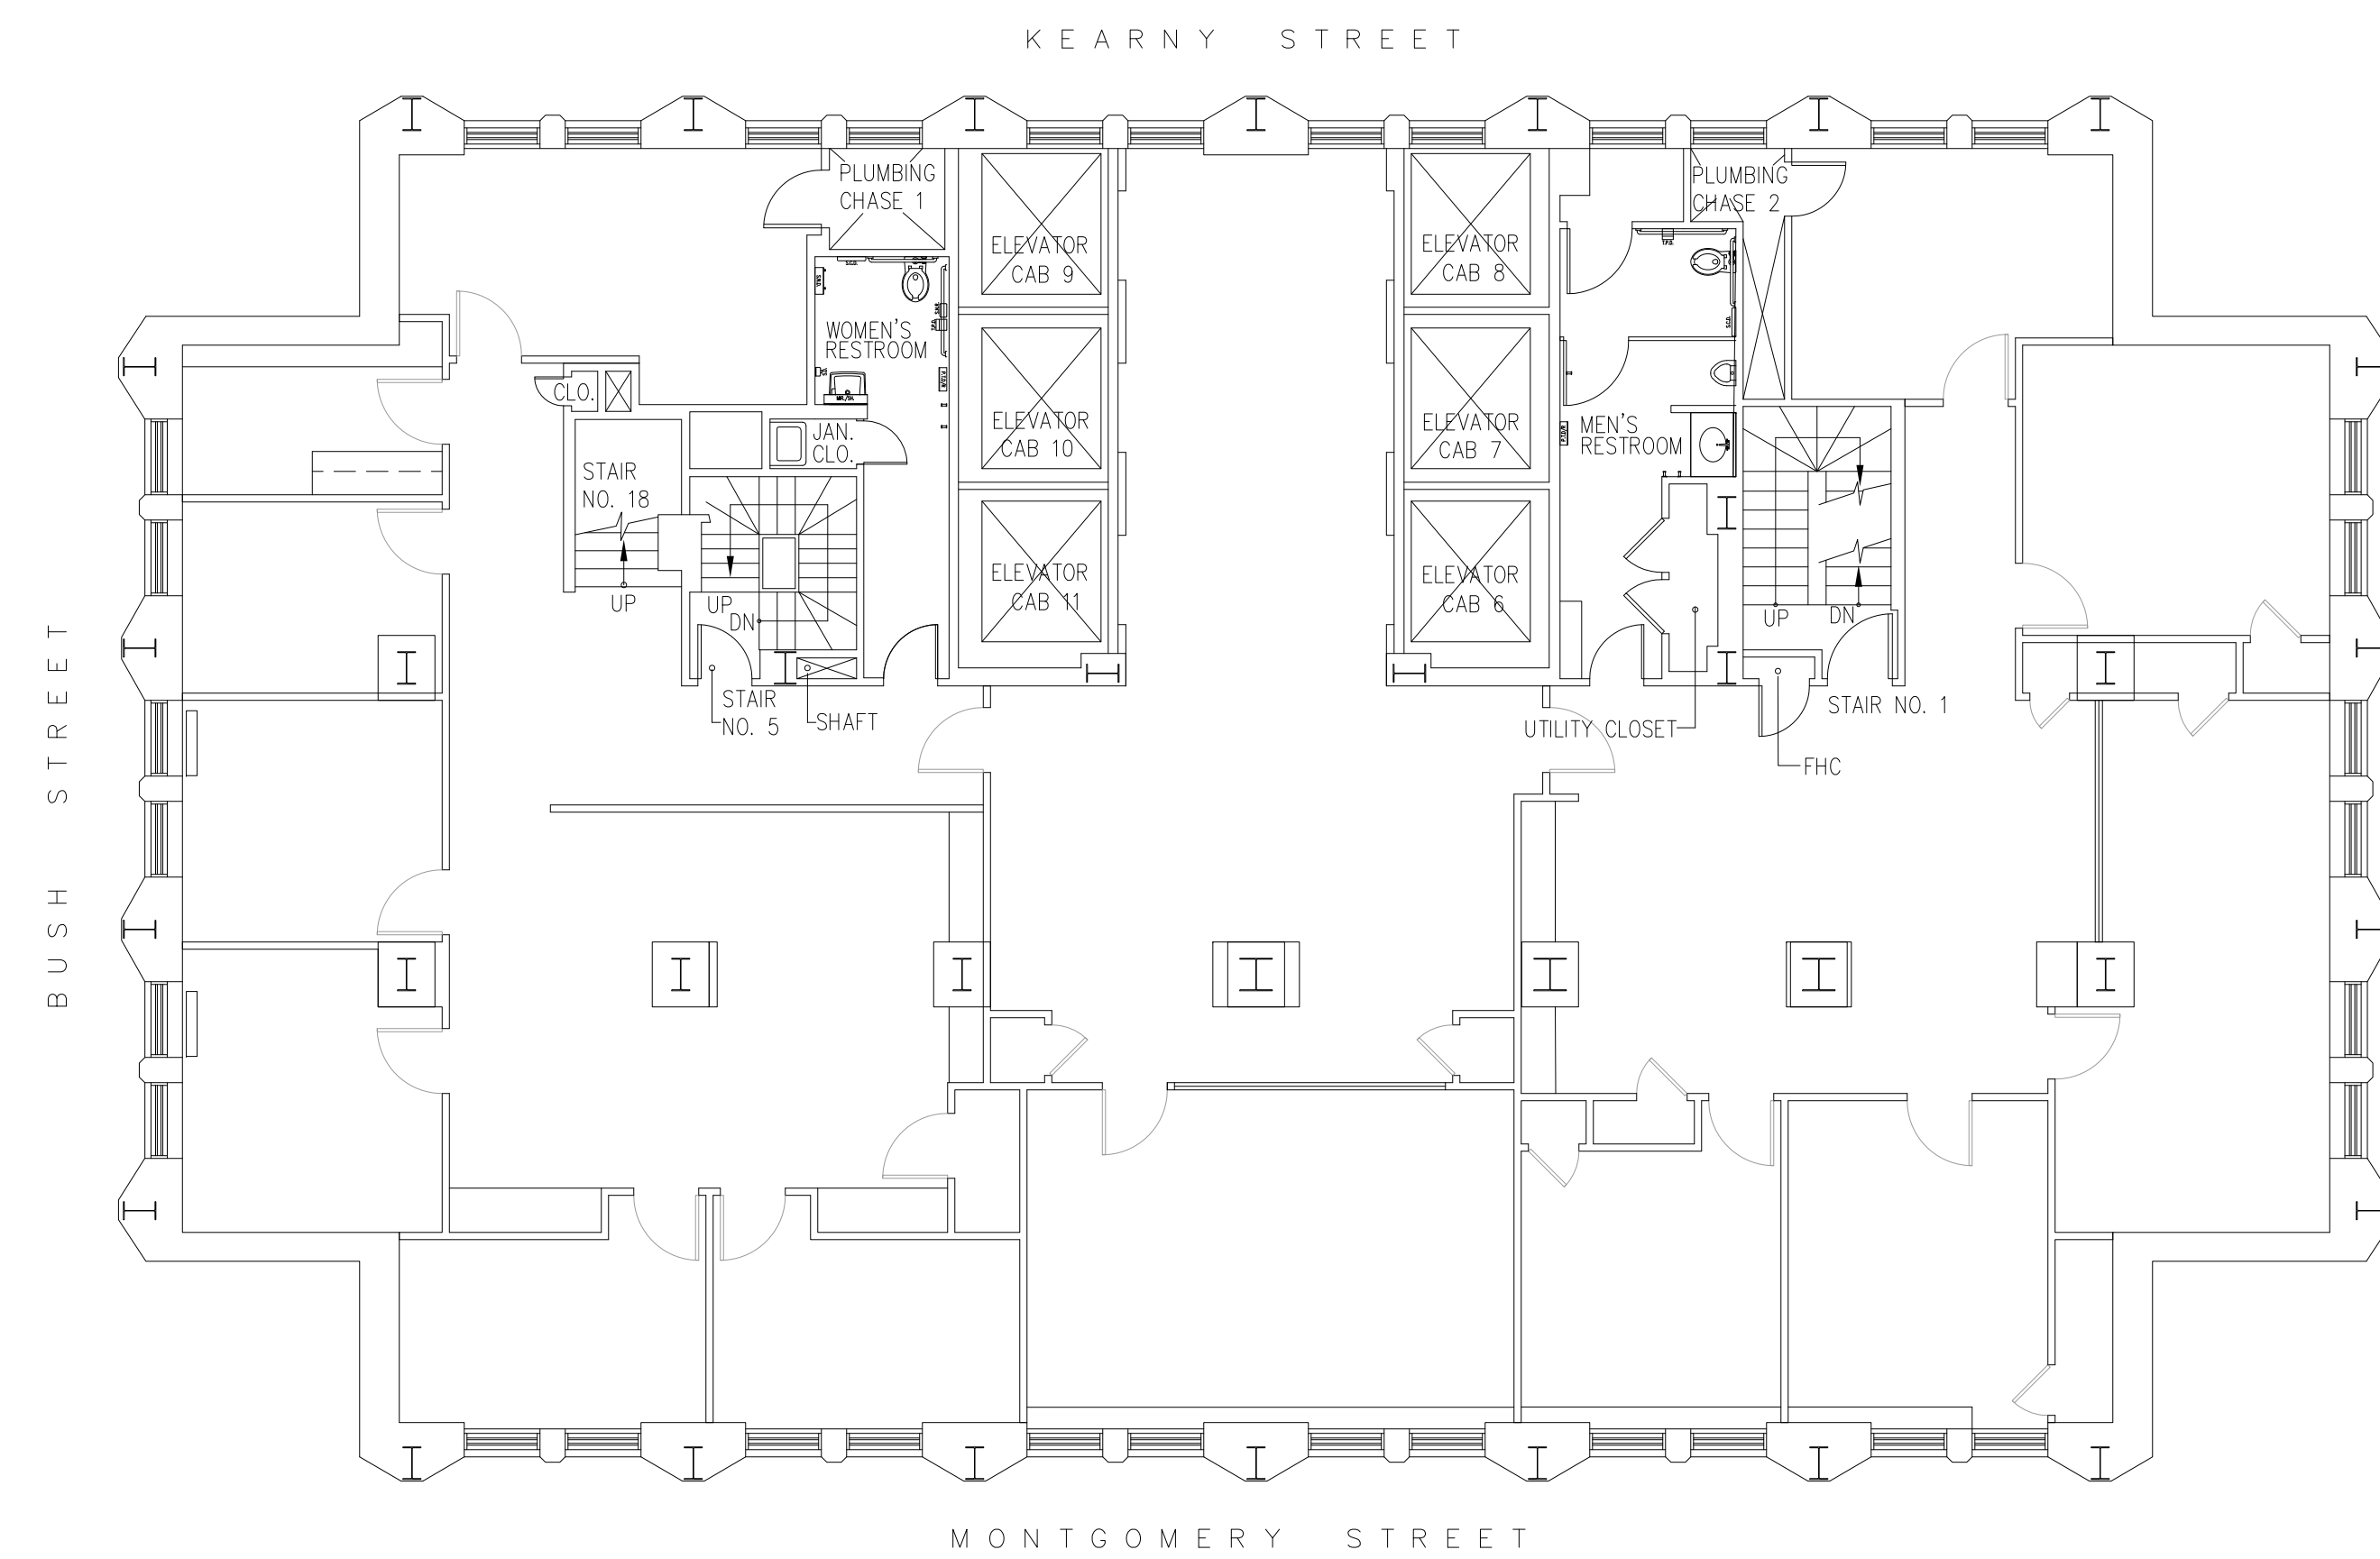

**FIELD VERIFICATION OF ALL DIMENSIONS AND EXISTING CONDITIONS ARE THE RESPONSIBILITY OF ALL DESIGN AND/OR CONSTRUCTION PROFESSIONALS USING THESE DOCUMENTS. NO REPRESENTATION OF THE ACCURACY OF THESE DOCUMENTS IS PROVIDED.**

SRS Archive	01/26/04
Restroom Retrofit Update	11/08/04
.	.
.	.
PROJECT NUMBER:  
 BUILDING:  
**Russ Building**  
 235 Montgomery St.  
 San Francisco, CA

**Suite 3000**

**AS BUILT PLAN**  
 FILE NAME:  
 I\_30FBAB.dwg



PLOT PLAN  
 CONSULTANT  
 .  
 .  
 .

DRAWN BY: . SCALE: 1/8"=1'-0"

**30** FLOOR NUMBER **AB-1** SHEET NUMBER