


6th Floor – Suite 630 – 3,629 rsf As-Built Plan

RUSS BUILDING
235 MONTGOMERY

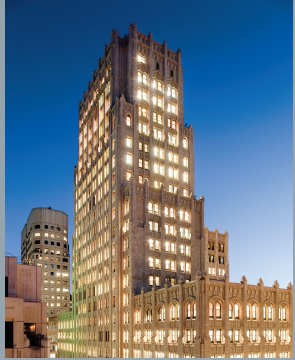


www.russbldg.com

Jim Collins
415.352.7239

jcollins@shorenstein.com
CA RE 00860991


Tom McDonnell
415.772.7086

tmcdonnell@shorenstein.com
CA RE 01011145

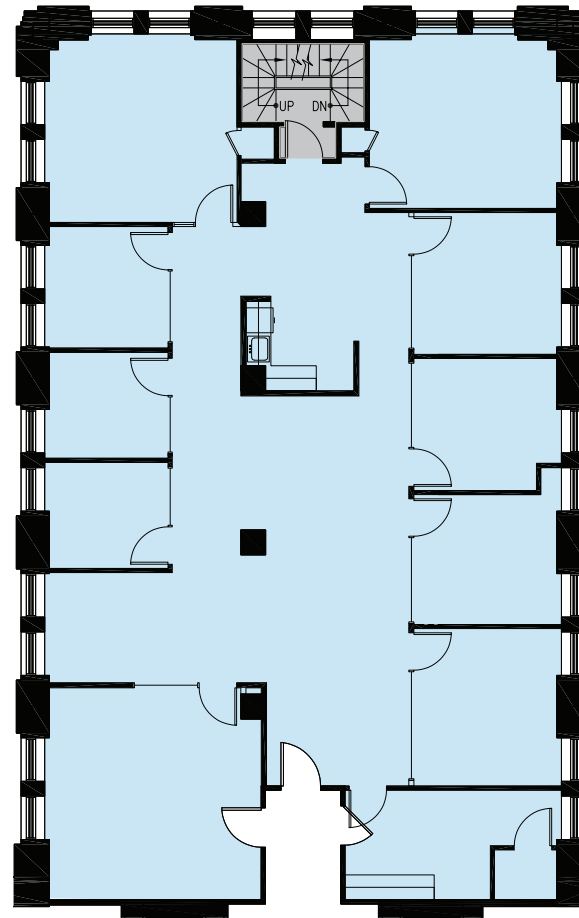

- 9 Window-line private offices
- Conference room
- Reception area
- Breakroom, copy/coffee area

This floor plan has been obtained from sources believed reliable, but has not been verified for accuracy or completeness. You should conduct a careful, independent investigation of the property and the floor plan, and verify all information prior to designing or building based on the information shown. Any reliance on this information is solely at your own risk.

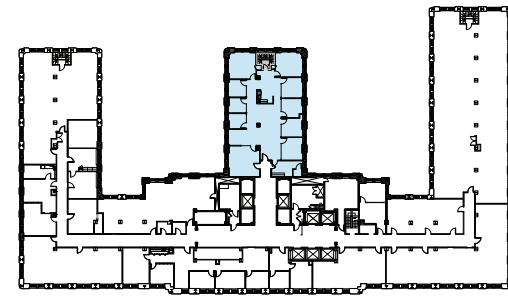

235 Montgomery St.
San Francisco, CA 94104