


GENERAL NOTES:

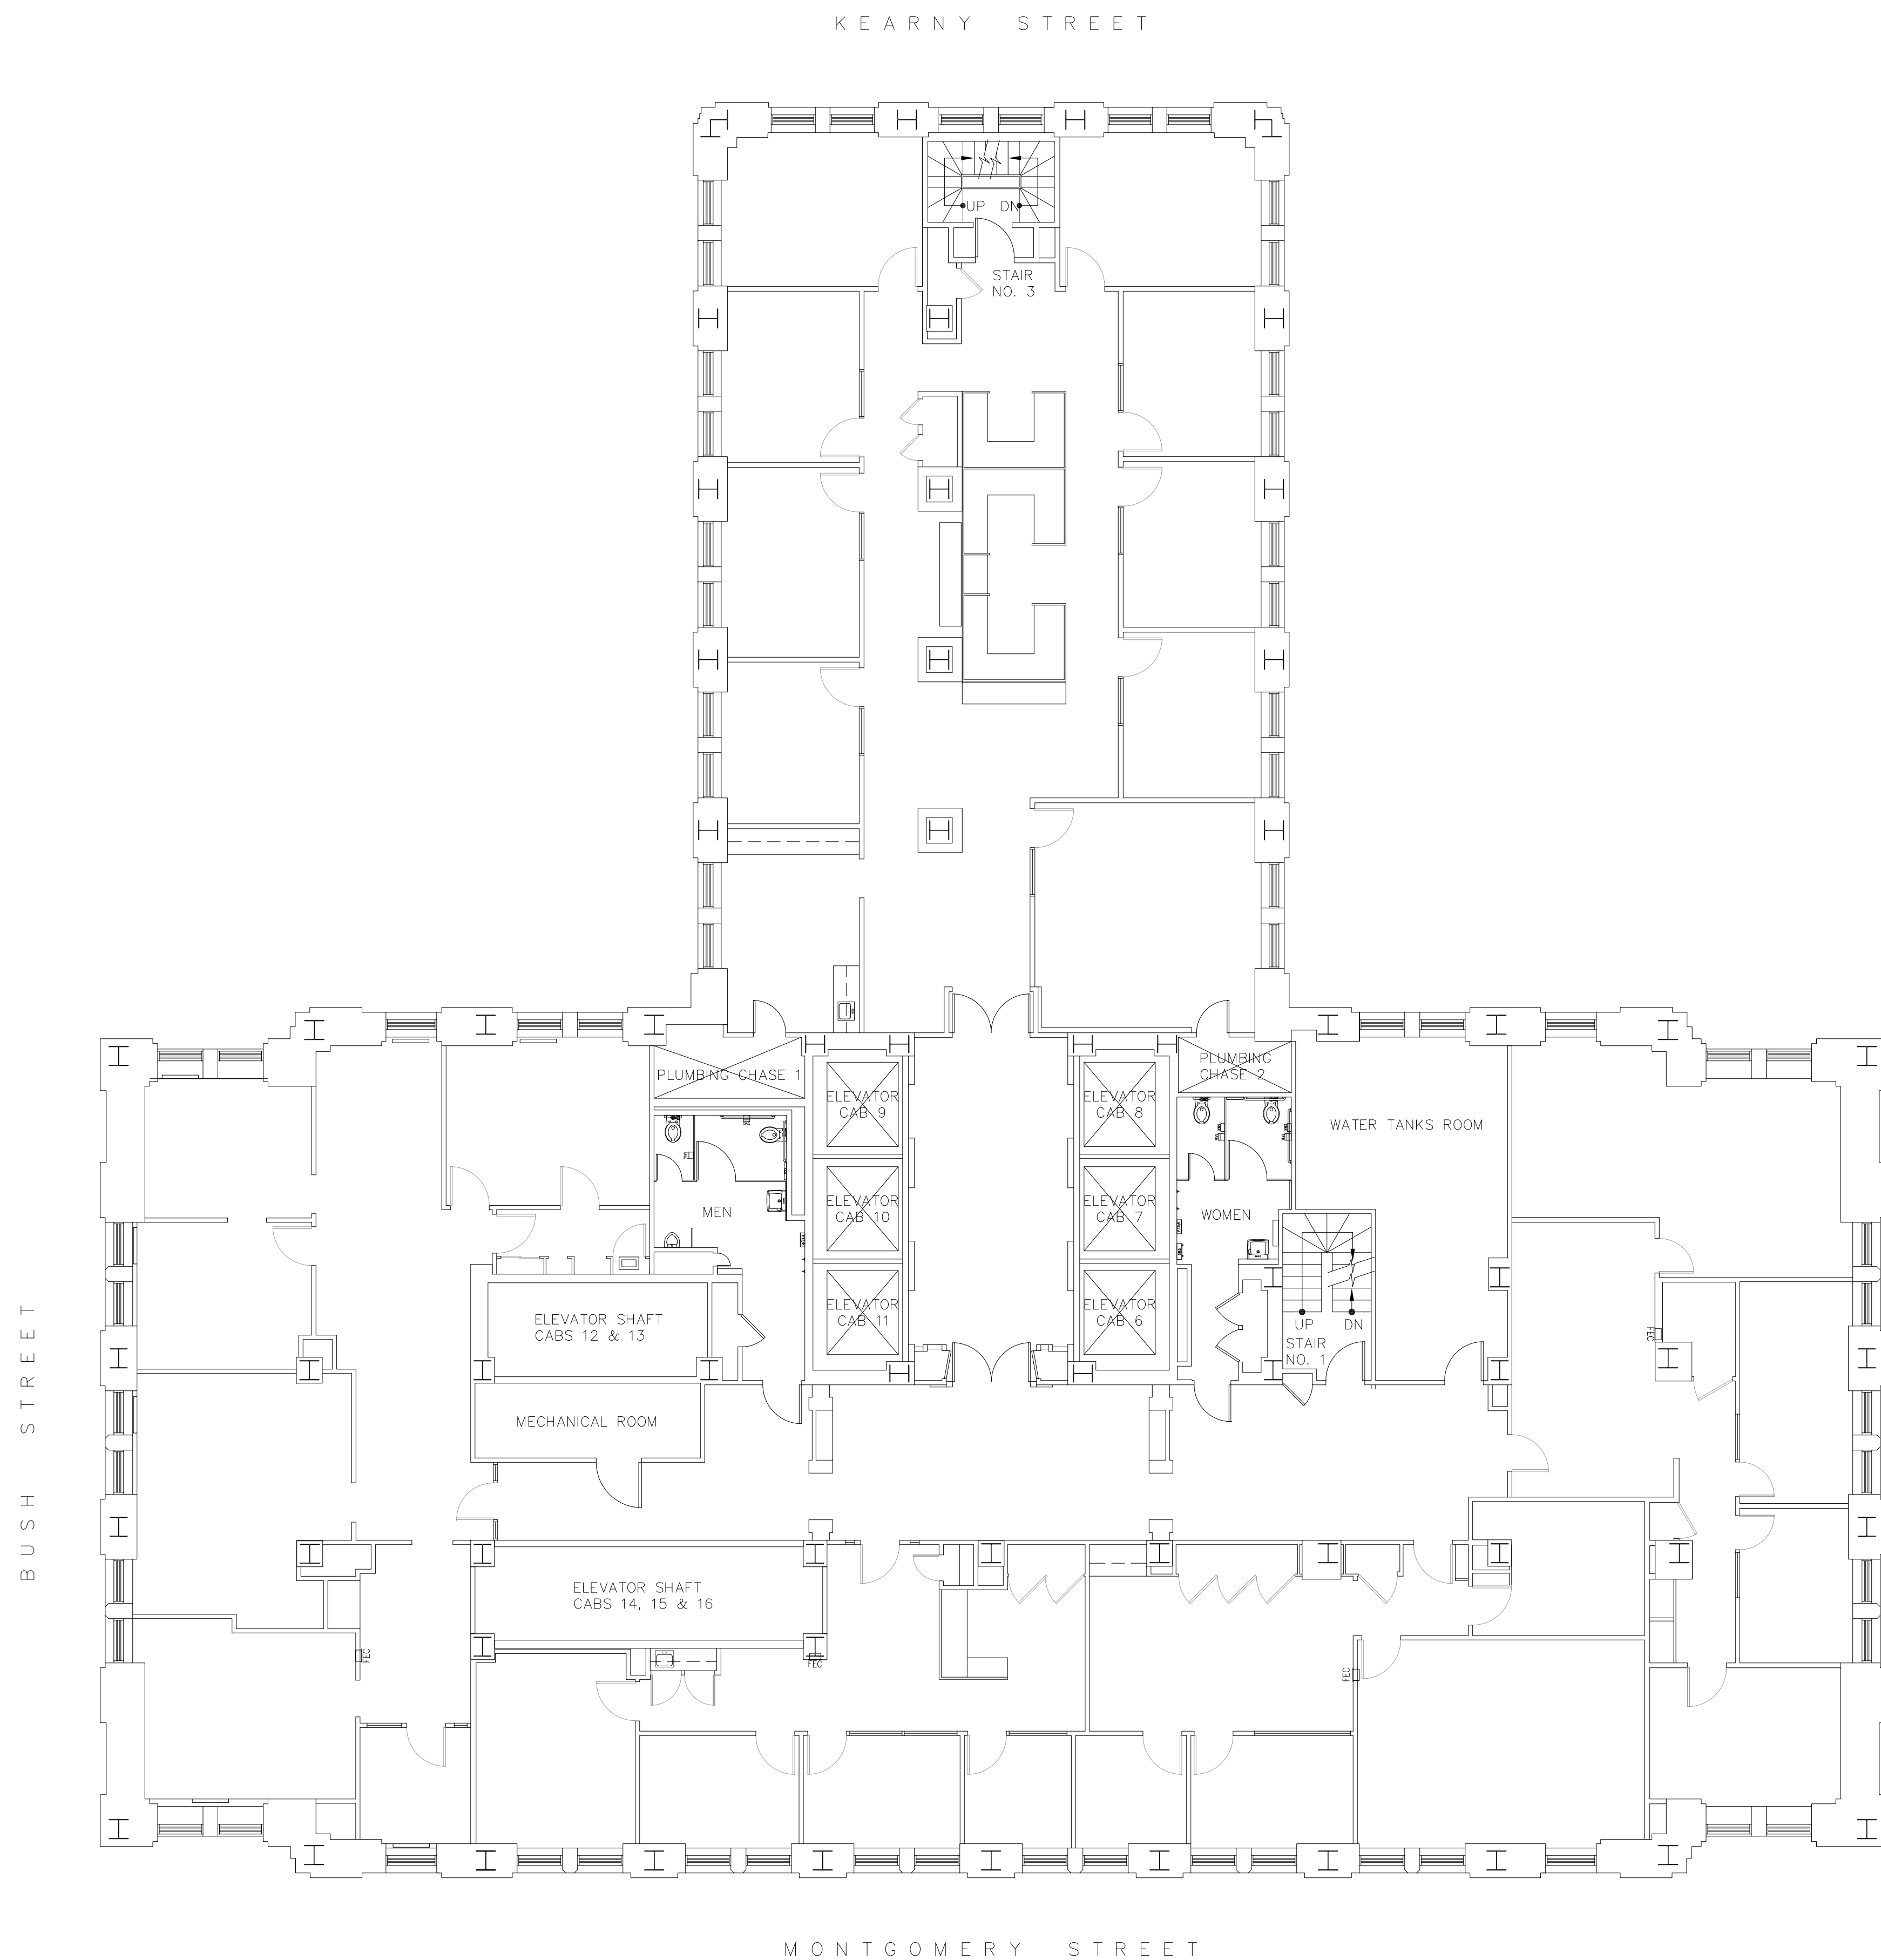

FIELD VERIFICATION OF ALL DIMENSIONS AND EXISTING CONDITIONS ARE THE RESPONSIBILITY OF ALL DESIGN AND/OR CONSTRUCTION PROFESSIONALS USING THESE DOCUMENTS. NO REPRESENTATION OF THE ACCURACY OF THESE DOCUMENTS IS PROVIDED.

SRS Archive	11/8/21
.	.
.	.
PROJECT NUMBER: ..
 BUILDING:
Russ Building
 235 Montgomery Street
 San Francisco, CA 94104
 TENANT:

Suite 1800

AS BUILT PLAN
 FILE NAME:
 Russ Building_Floor 18_Suite 1800_As Built.dwg



PLOT PLAN
 CONSULTANT
 .
 .
 .

DRAWN BY: .. SCALE: 1/8"=1'-0"