


GENERAL NOTES:

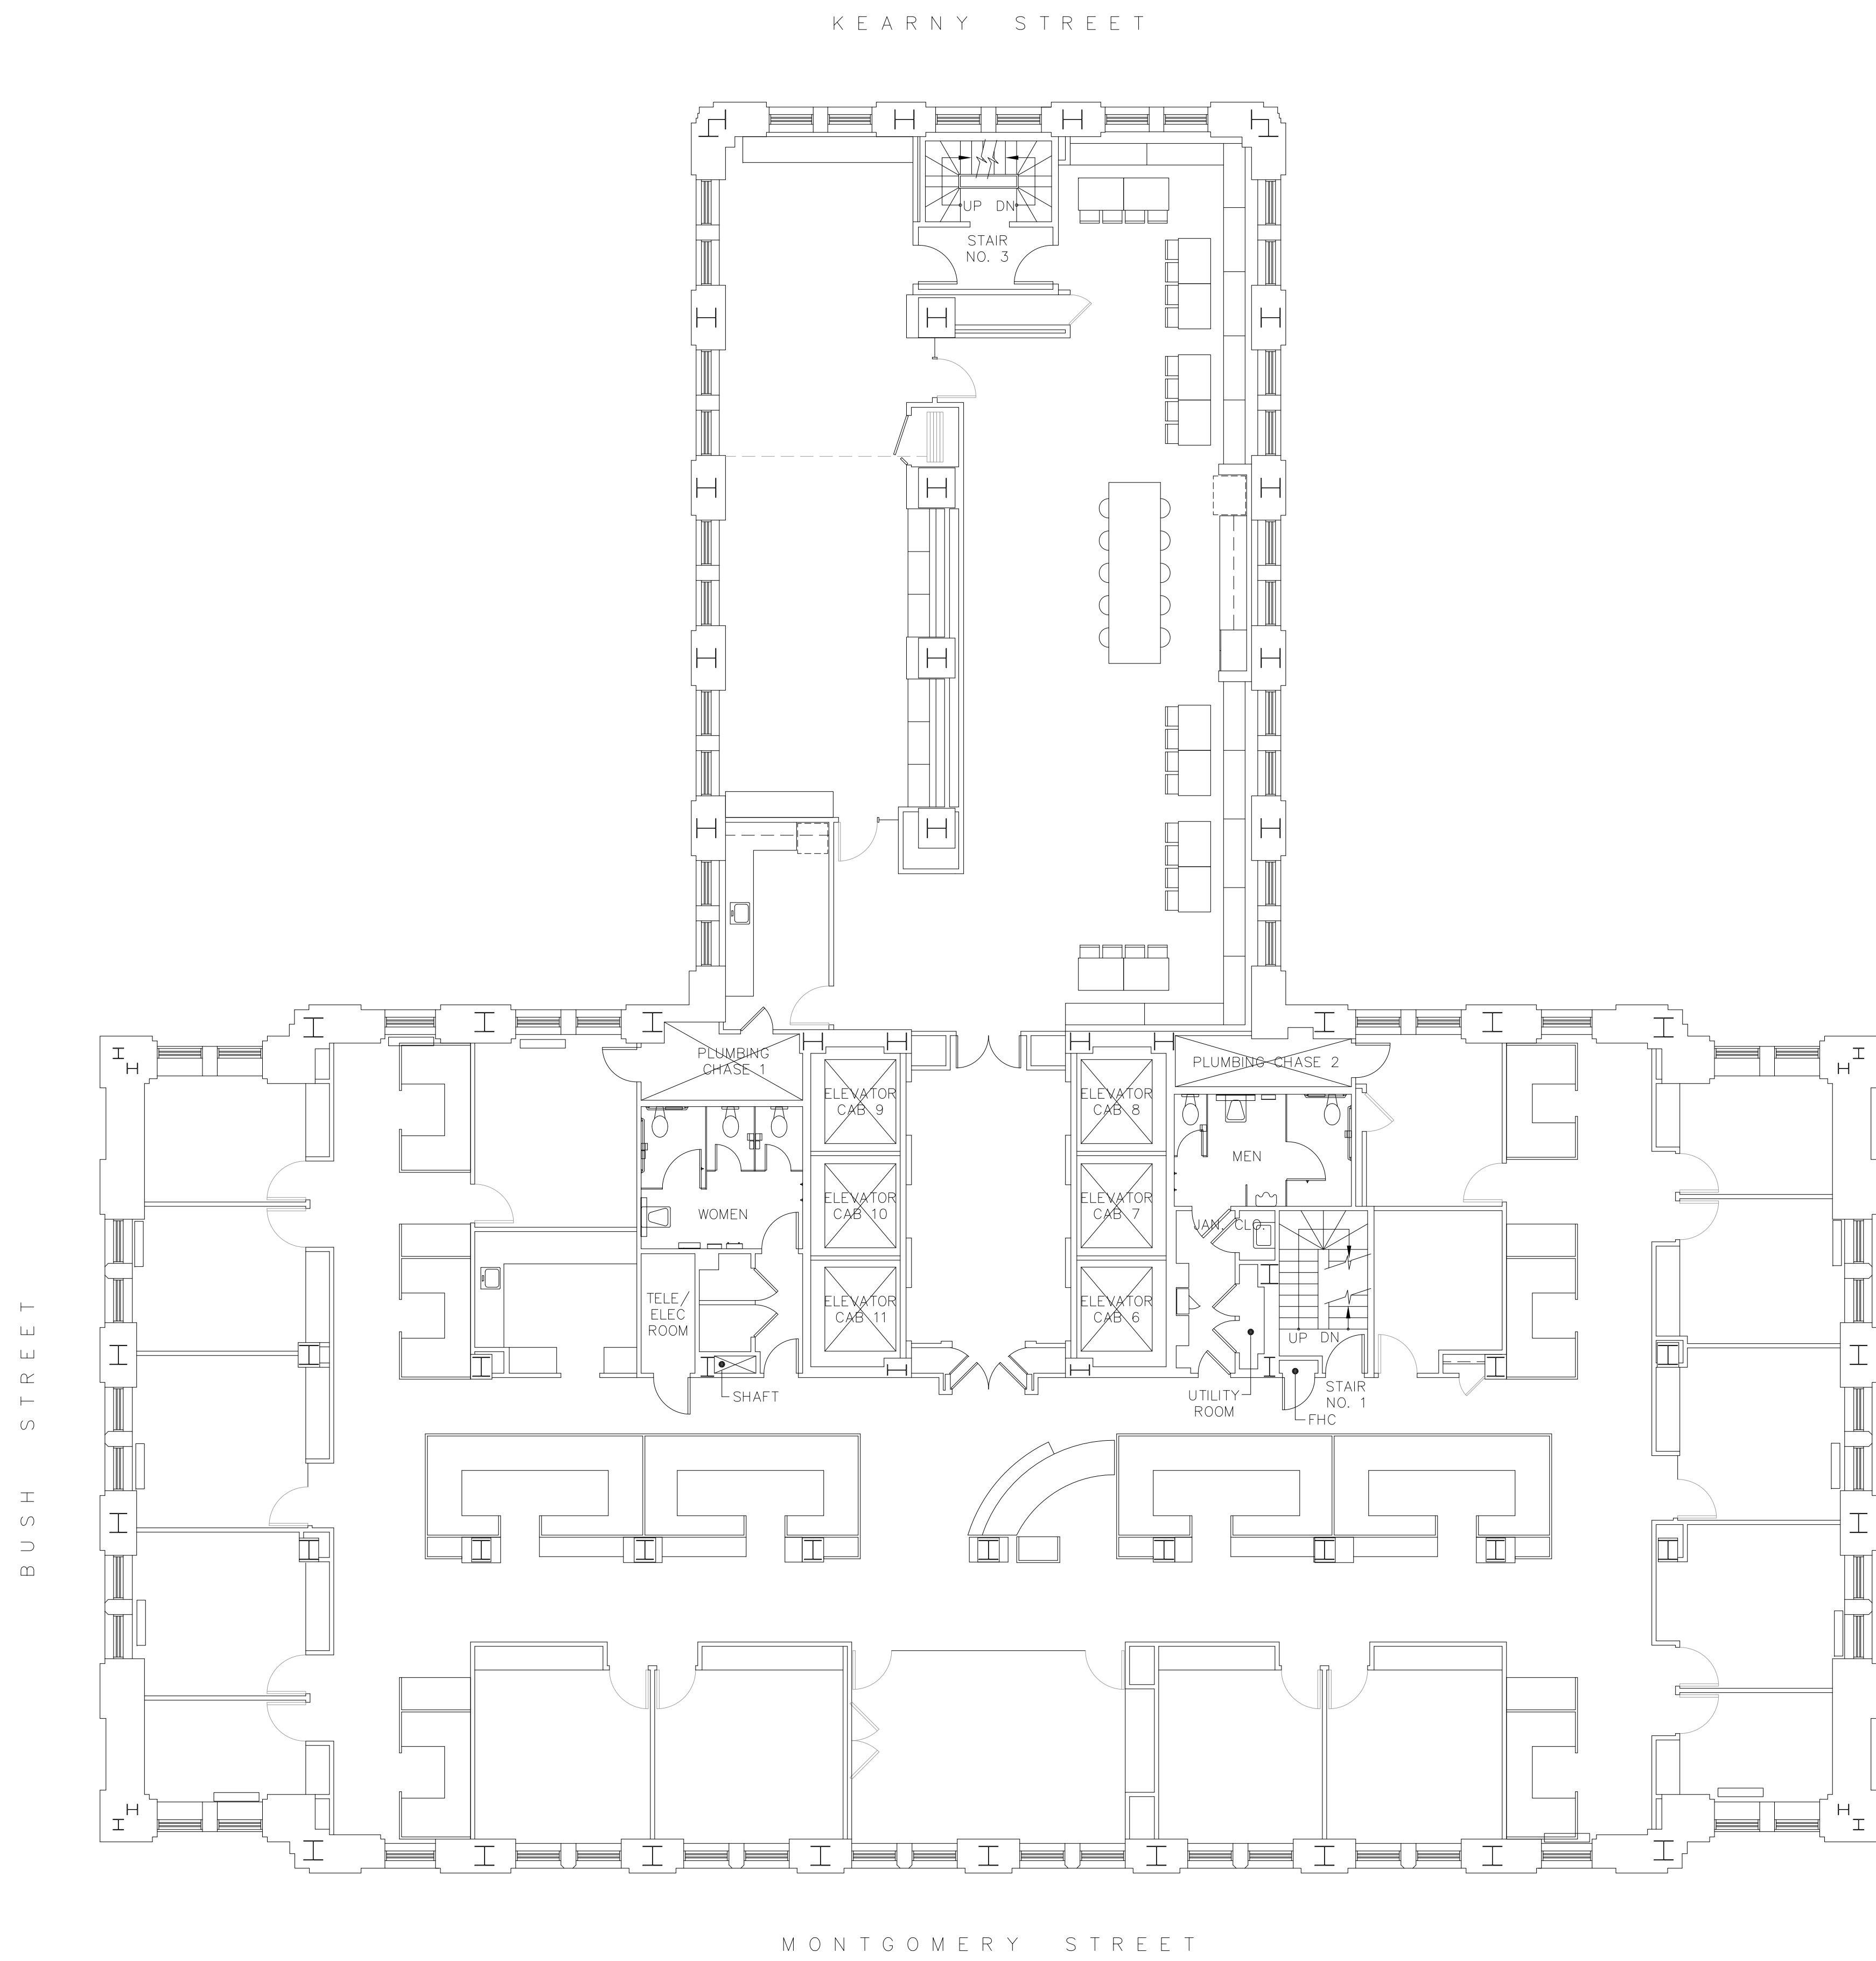

FIELD VERIFICATION OF ALL DIMENSIONS AND EXISTING CONDITIONS ARE THE RESPONSIBILITY OF ALL DESIGN AND/OR CONSTRUCTION PROFESSIONALS USING THESE DOCUMENTS. NO REPRESENTATION OF THE ACCURACY OF THESE DOCUMENTS IS PROVIDED.

SRS Archive	11/8/21
.	.
.	.
PROJECT NUMBER: .  
 BUILDING:  
**Russ Building**  
 235 Montgomery Street  
 San Francisco, CA 94104

Suite 2100

AS BUILT PLAN  
 FILE NAME:  
 Russ Building\_Floor 21\_Suite 2100\_As Built.dwg



PLOT PLAN  
 CONSULTANT  
 .  
 .  
 .

DRAWN BY: . SCALE: 1/8"=1'-0"