




10 South Eighth Street
Minneapolis MN 55402

t 612_339_2257
f 612_349_2930
sheadesign.com



UNILEV MANAGEMENT CORP

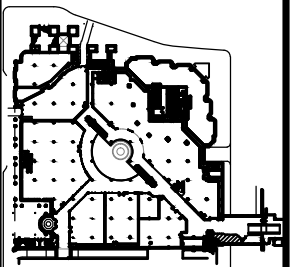

KEY PLAN

AS-BUILT
FLOOR PLAN
FLOOR 2
SUITE #280
VACANT
663 USF
769 RSF


comm. no.: 6370.01

scale: NOT TO SCALE

date: 4.22.15

revision date:

drawn by:

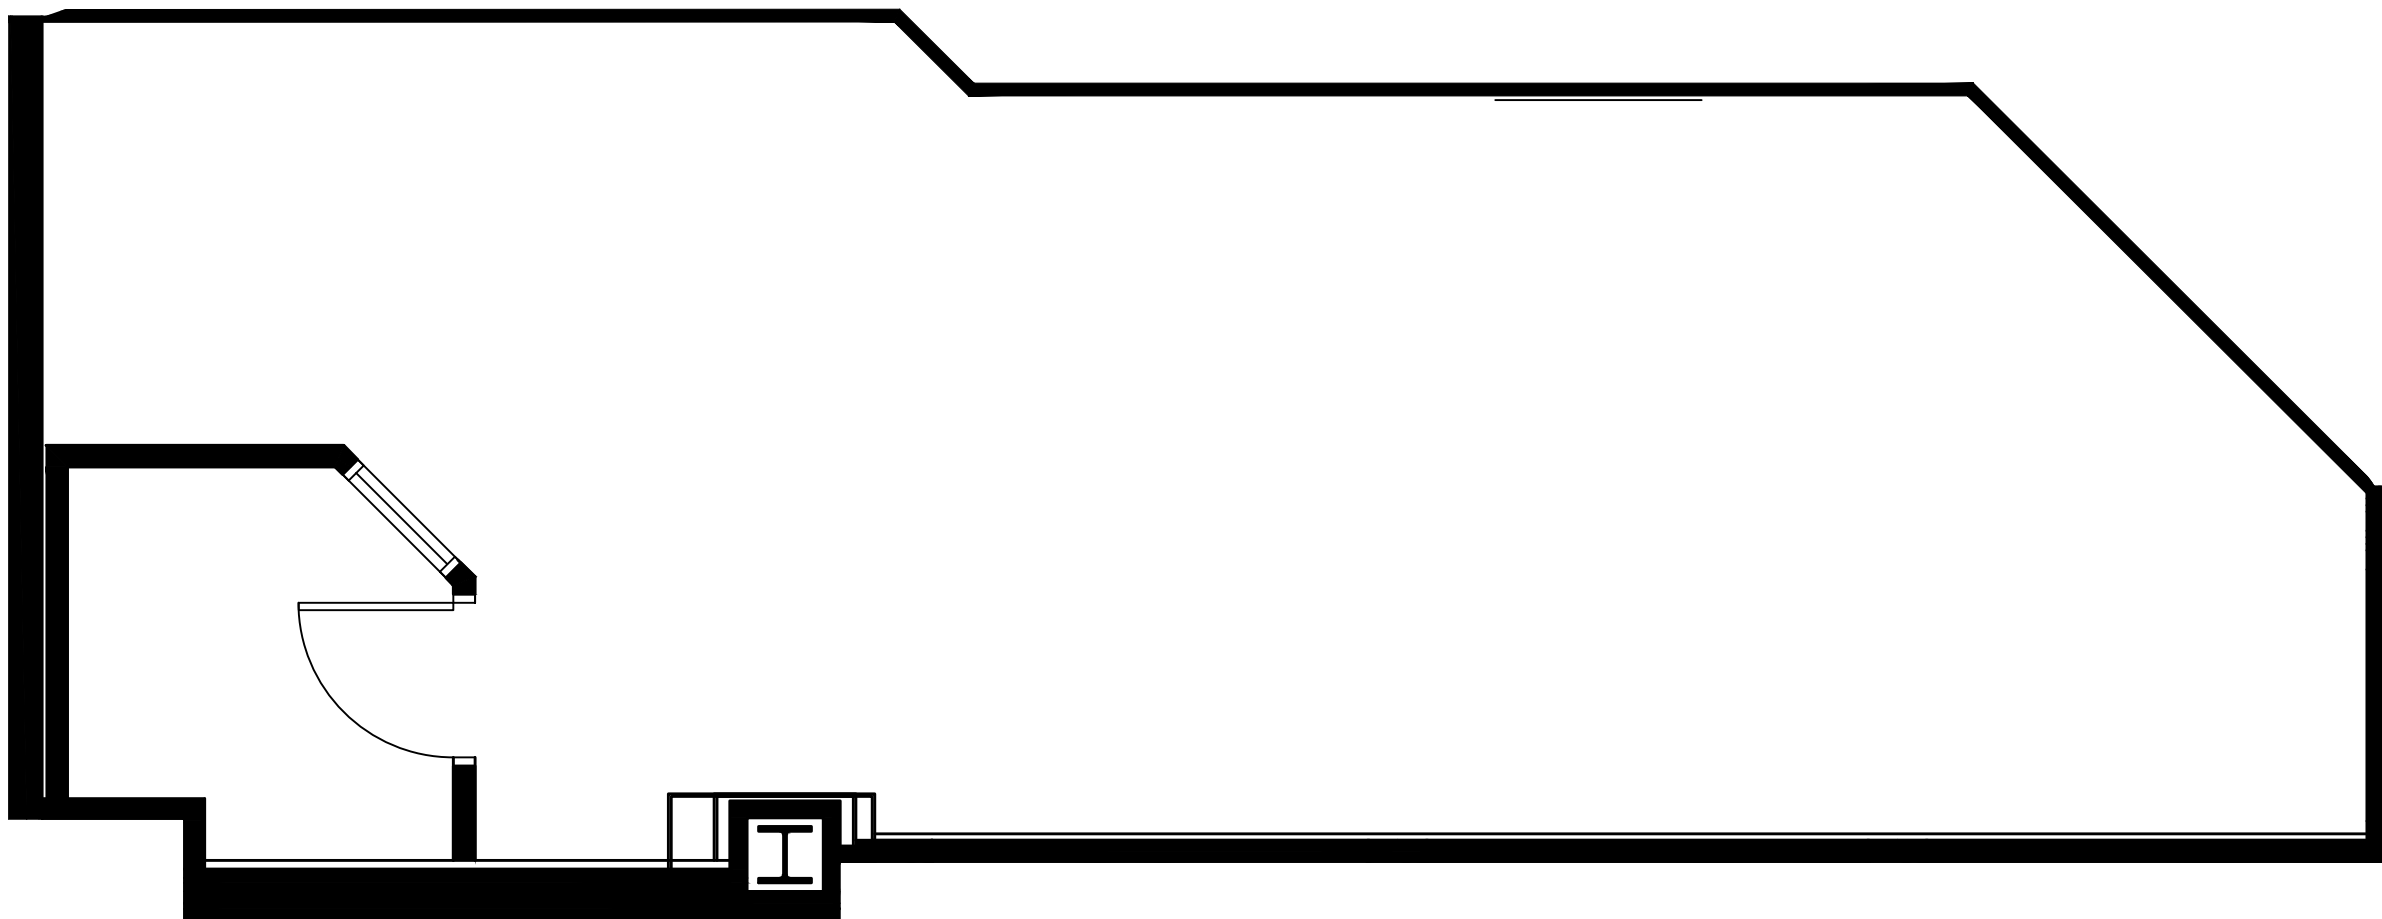

AB-280