



Key Plan

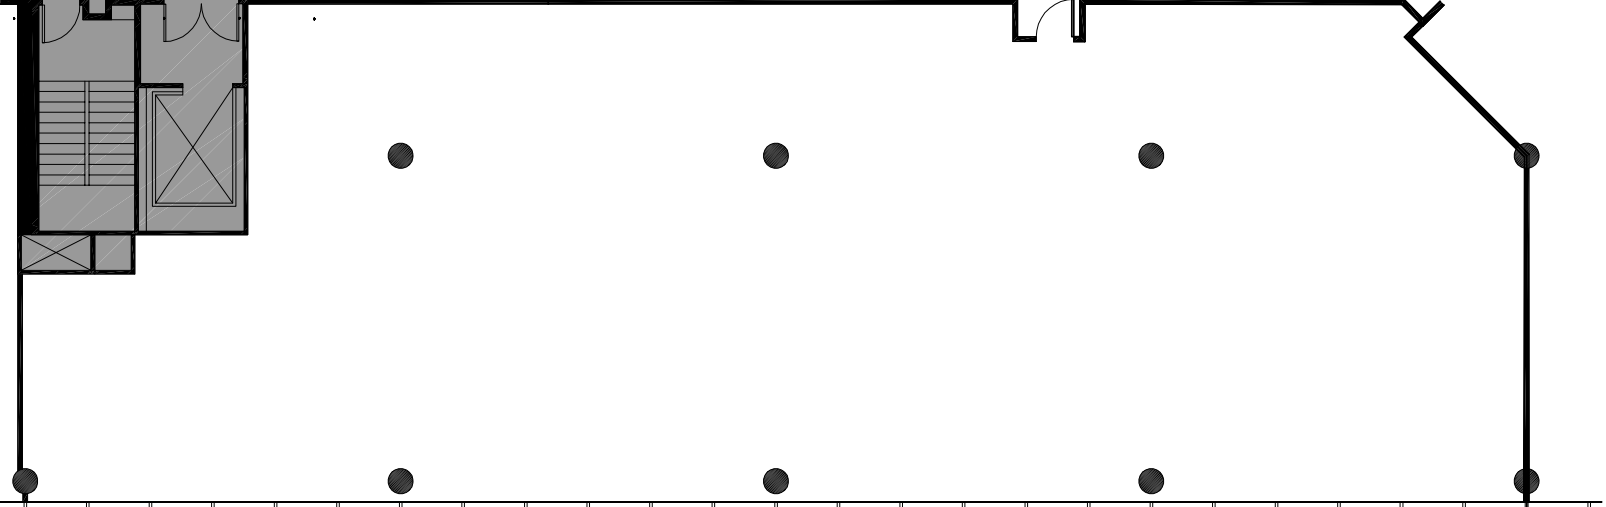

Building North

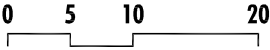

Jeff Keppen 404.504.7923
Katherine Lynch 404.504.5971
Nicole Goldsmith 404.504.7923

NELSON

Concourse I • Suite 645 • 5,269 RSF

As Built