

25th Floor – Suite 2550 – 1,868 RSF AS BUILT PLAN

50 CALIFORNIA
STREET



Jim Collins

415.352.7239

jcollins@shorenstein.com


CA RE 00860991

Tom McDonnell


415.772.7086

tmcdonnell@shorenstein.com

CA RE 01011145

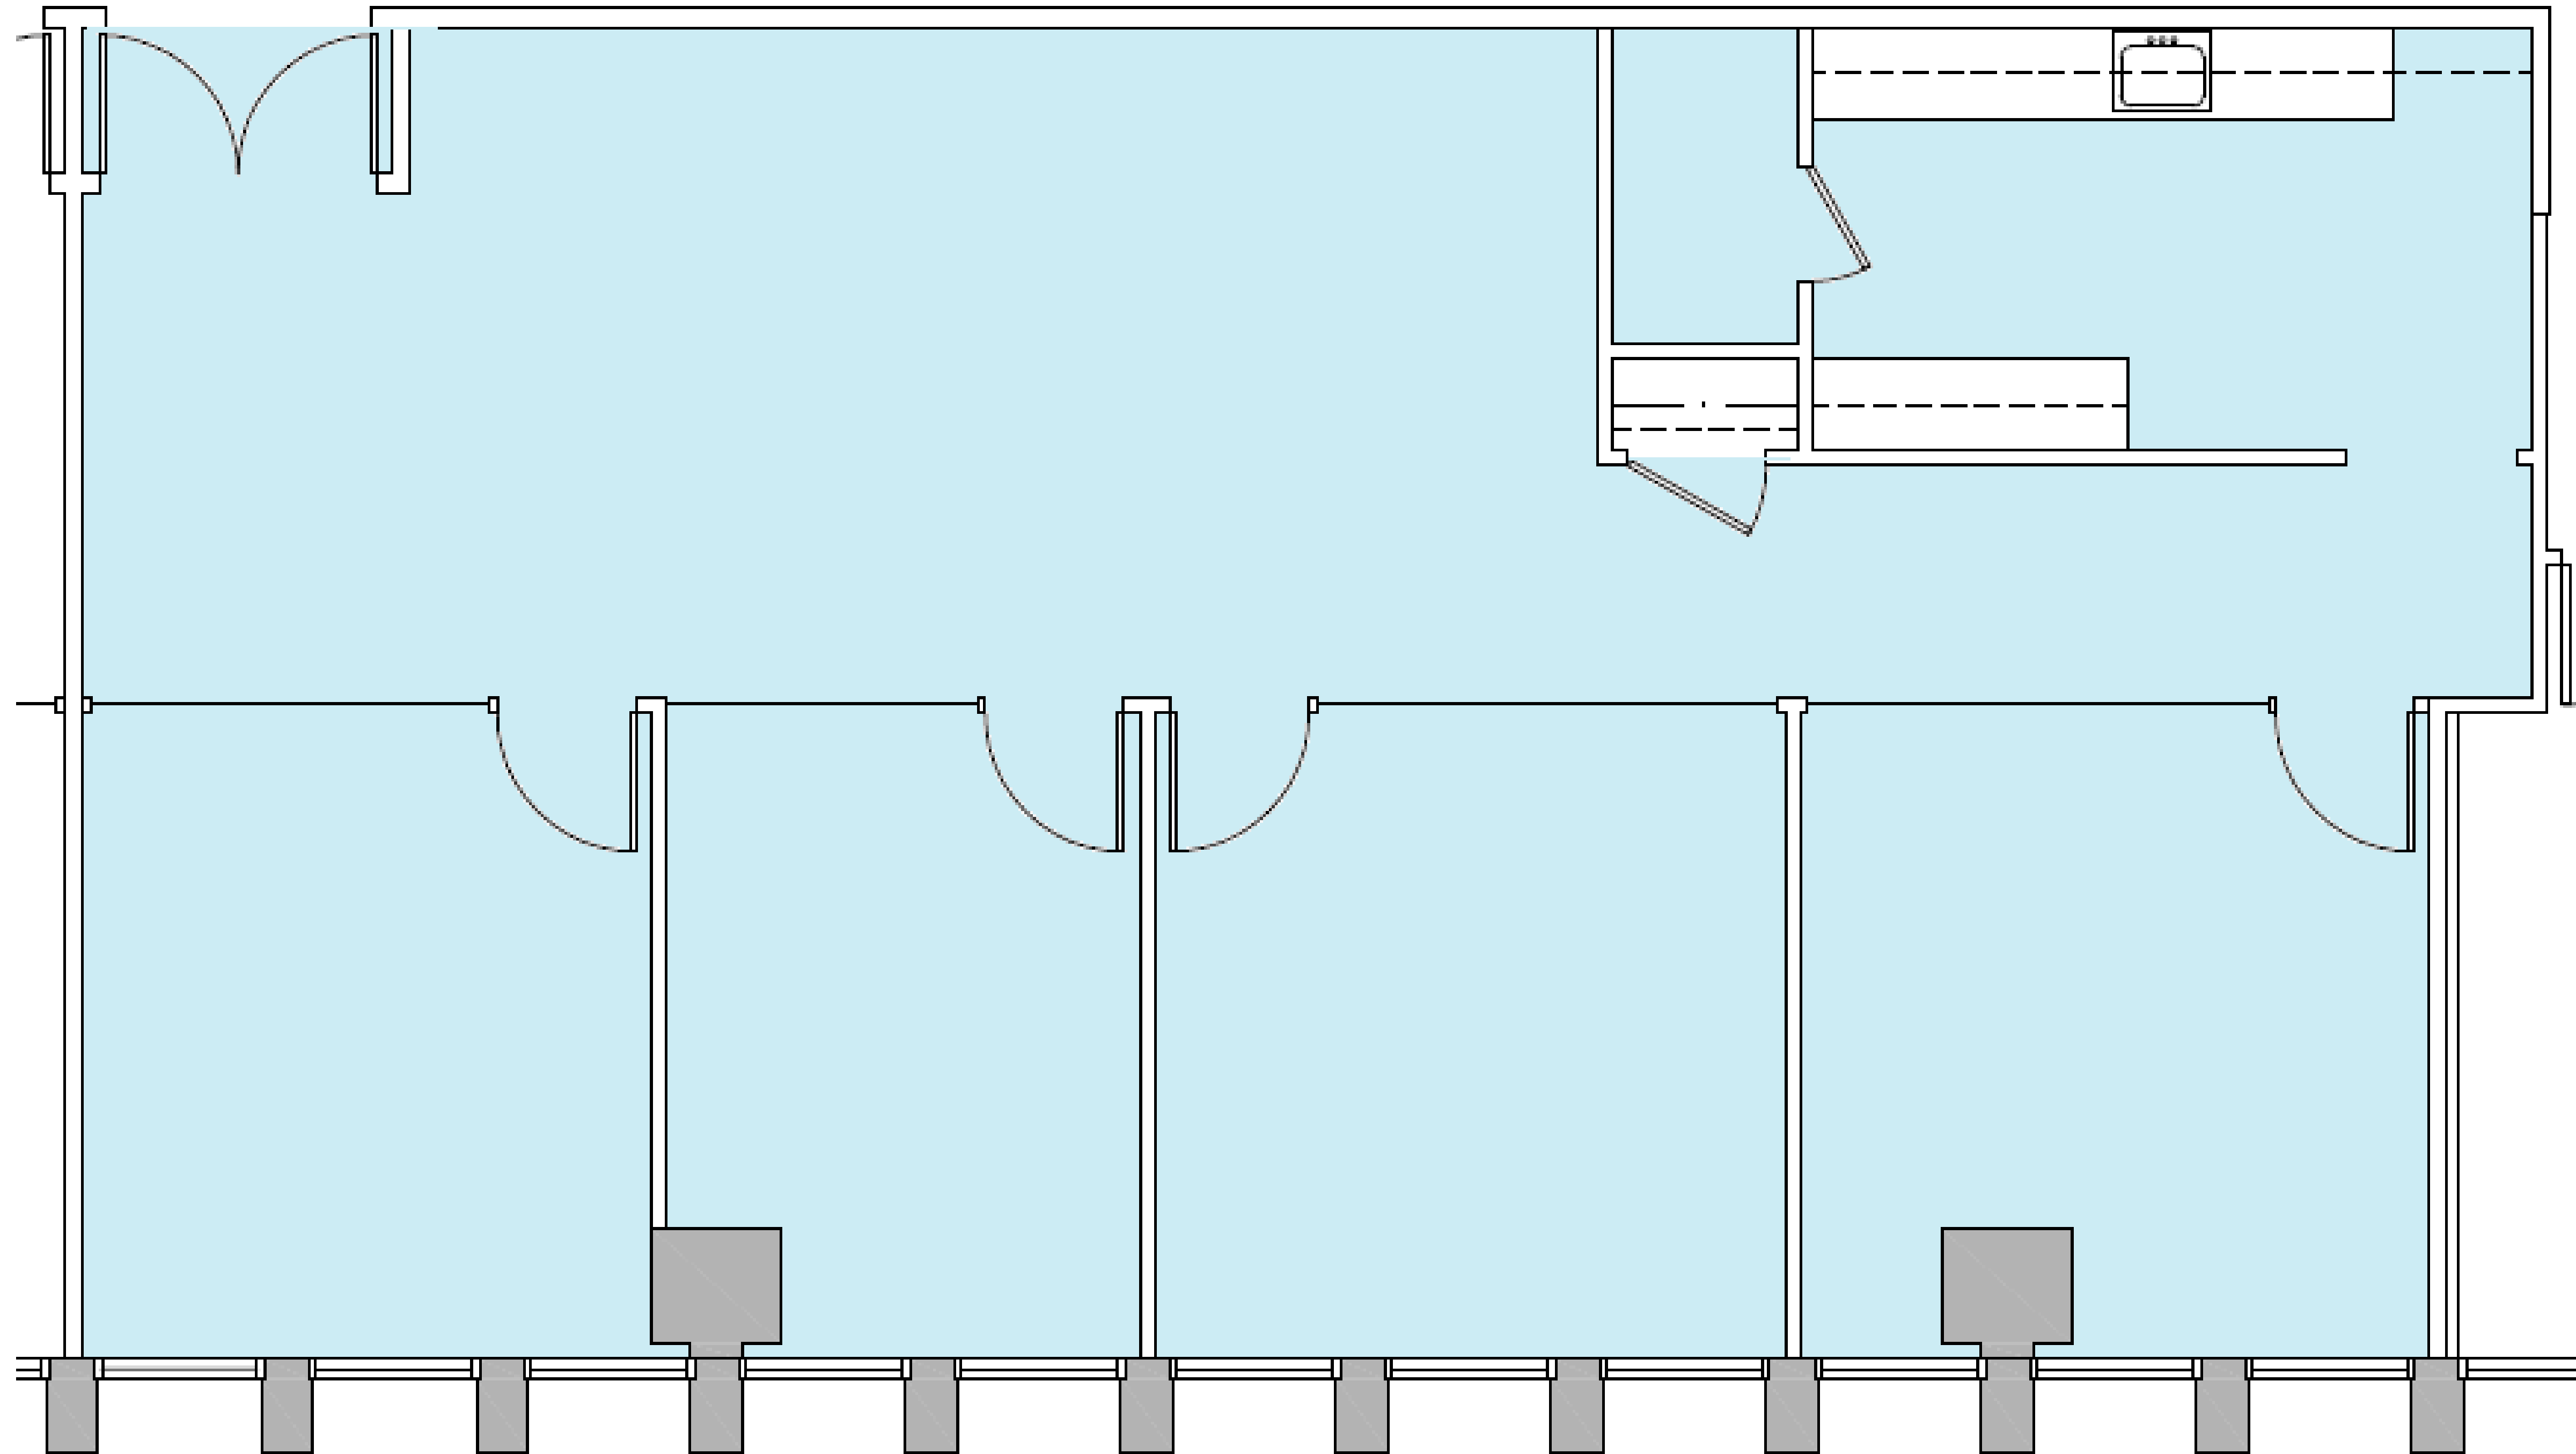

4 Window Line Offices
Open Workspace
Kitchen/Break Area
Server Closet

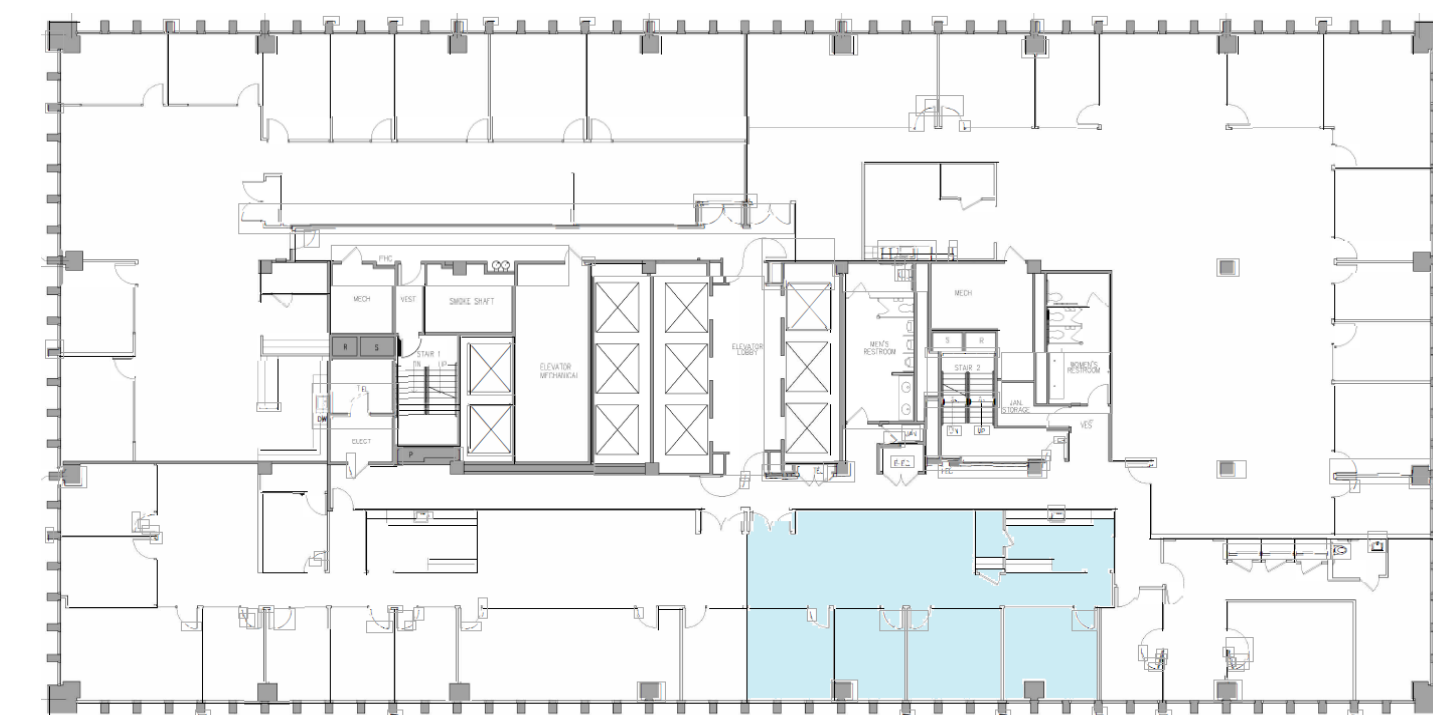

235 Montgomery St,
San Francisco, CA 94104