




10 south eighth street
minneapolis, mn
55402

T 612 339 2257
F 612 349 2930

www.shealink.com



UNILEV MANAGEMENT CORP

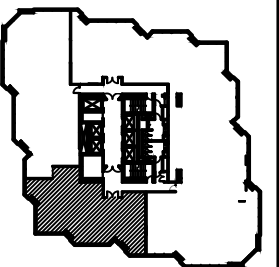

KEY PLAN
AS-BUILT
FLOOR PLAN
FLOOR 30
SUITE #3050
VACANT

2,358 RSF

comm. no.: 6370.01

scale: NOT TO SCALE


date: 2.12.14

revision date:

drawn by:

AB-3050

CATHEDRAL
↖

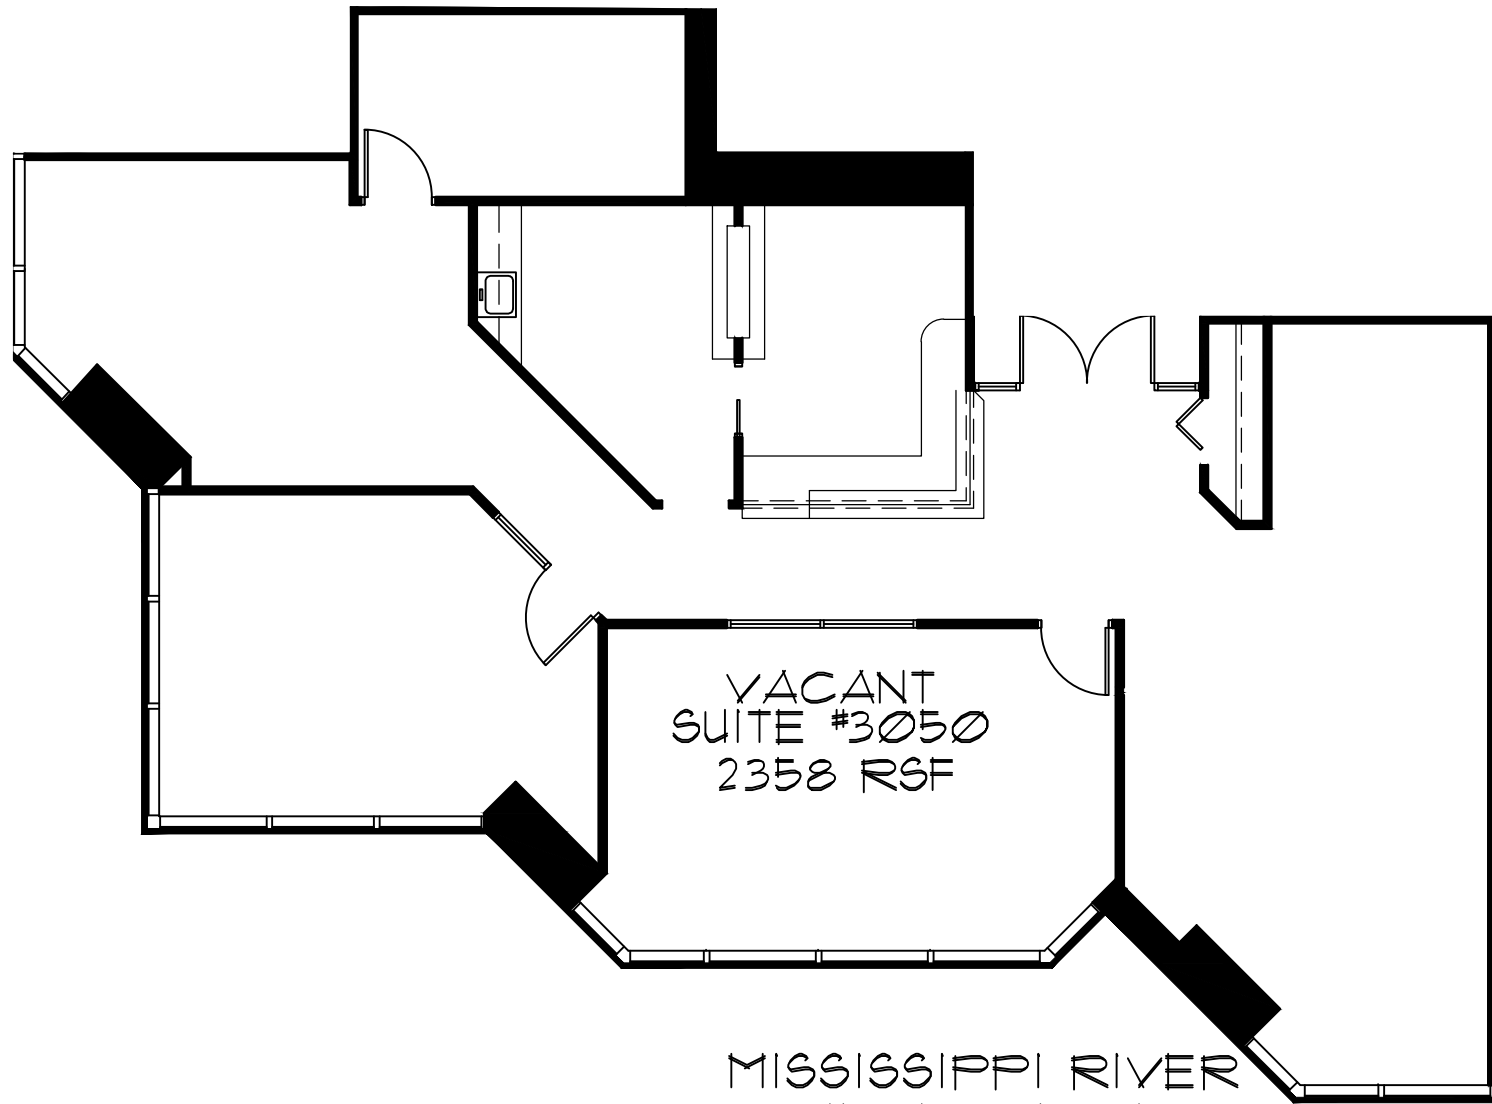

MISSISSIPPI RIVER
HIGH BRIDGE
↙

↙ ↘
MISSISSIPPI RIVER
LAFAYETTE BRIDGE