




10 South Eighth Street
Minneapolis MN 55402

t 612_339_2257
f 612_349_2930
sheadesign.com



UNILEV MANAGEMENT CORP

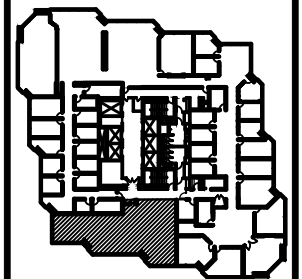

KEY PLAN
AS-BUILT
FLOOR PLAN

FLOOR 29
SUITE #2910
VACANT
1,557 USF
1,806 RSF


comm. no.: 6370.01

scale: NOT TO SCALE

date: 5.1.15

revision date:

drawn by:

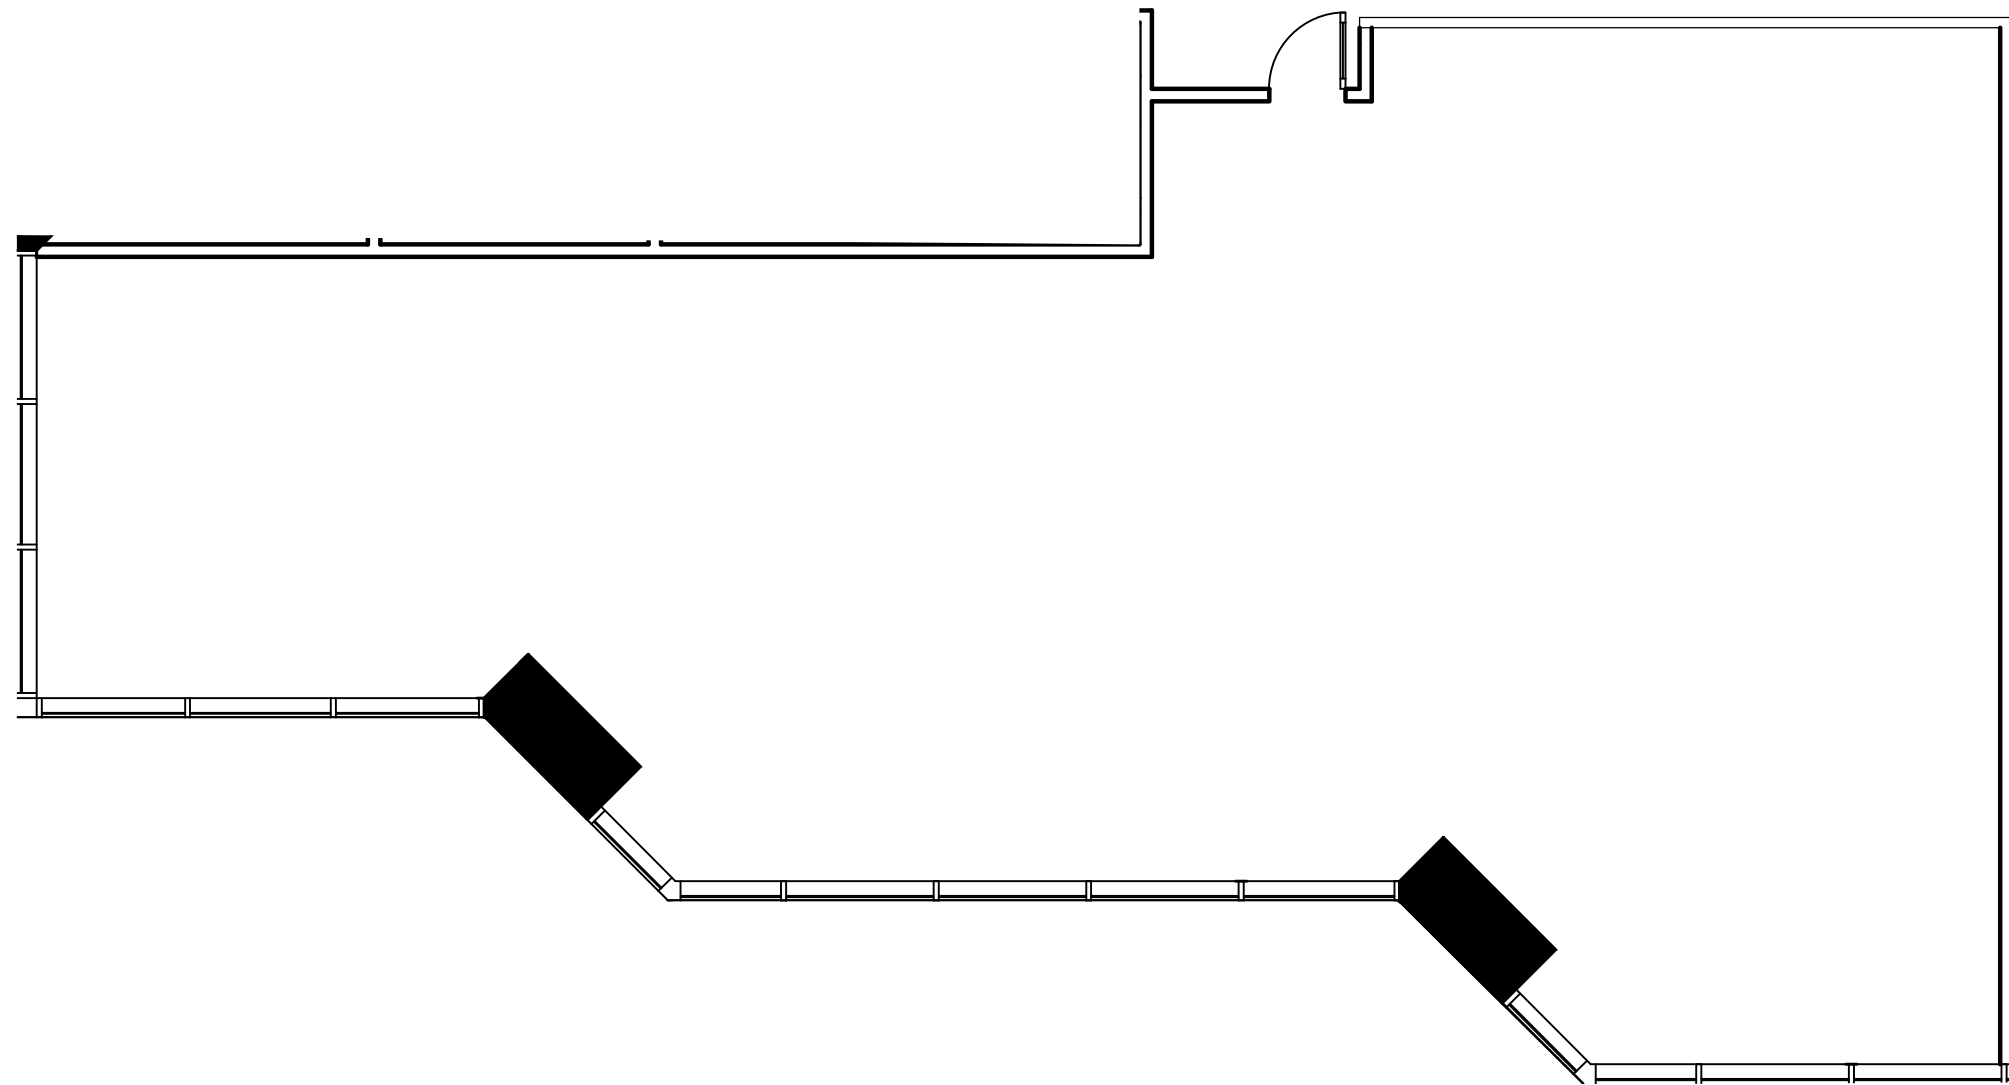

AB-2910