




10 South Eighth Street  
Minneapolis MN 55402

t 612\_339\_2257  
f 612\_349\_2930  
sheadesign.com



UNILEV MANAGEMENT CORP

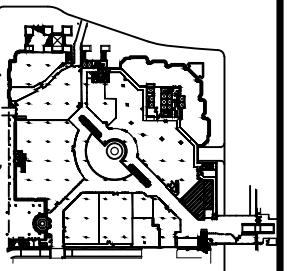

KEY PLAN  
AS-BUILT  
FLOOR PLAN  
FLOOR 2  
SUITE #210

1,953 USF  
2,265 RSF


comm. no.: 6370.01

scale: NOT TO SCALE

date: 12.2.16

revision date:

drawn by:

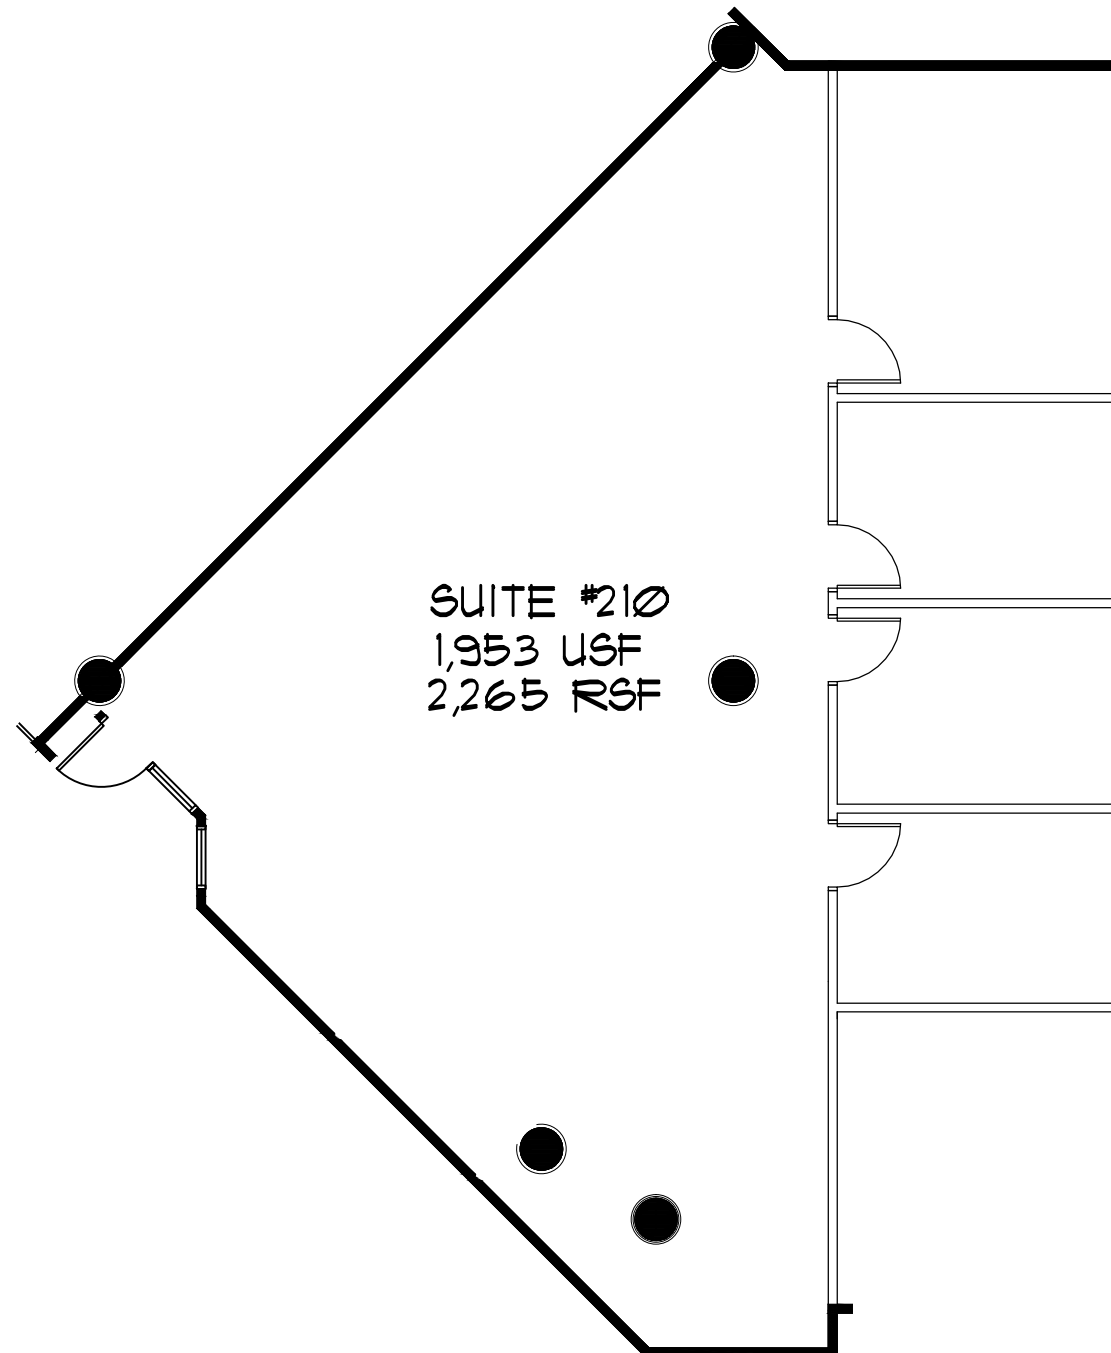

AB-210