





Executive Towers West I

1431 Opus Place
Downers Grove, Illinois

2nd Floor - Suite 215

Existing As-Built Conditions
2,718 RSF

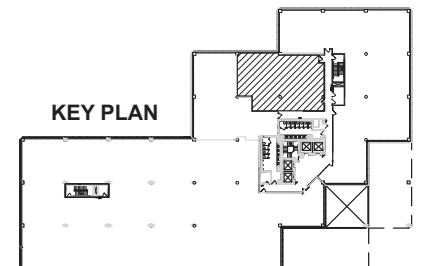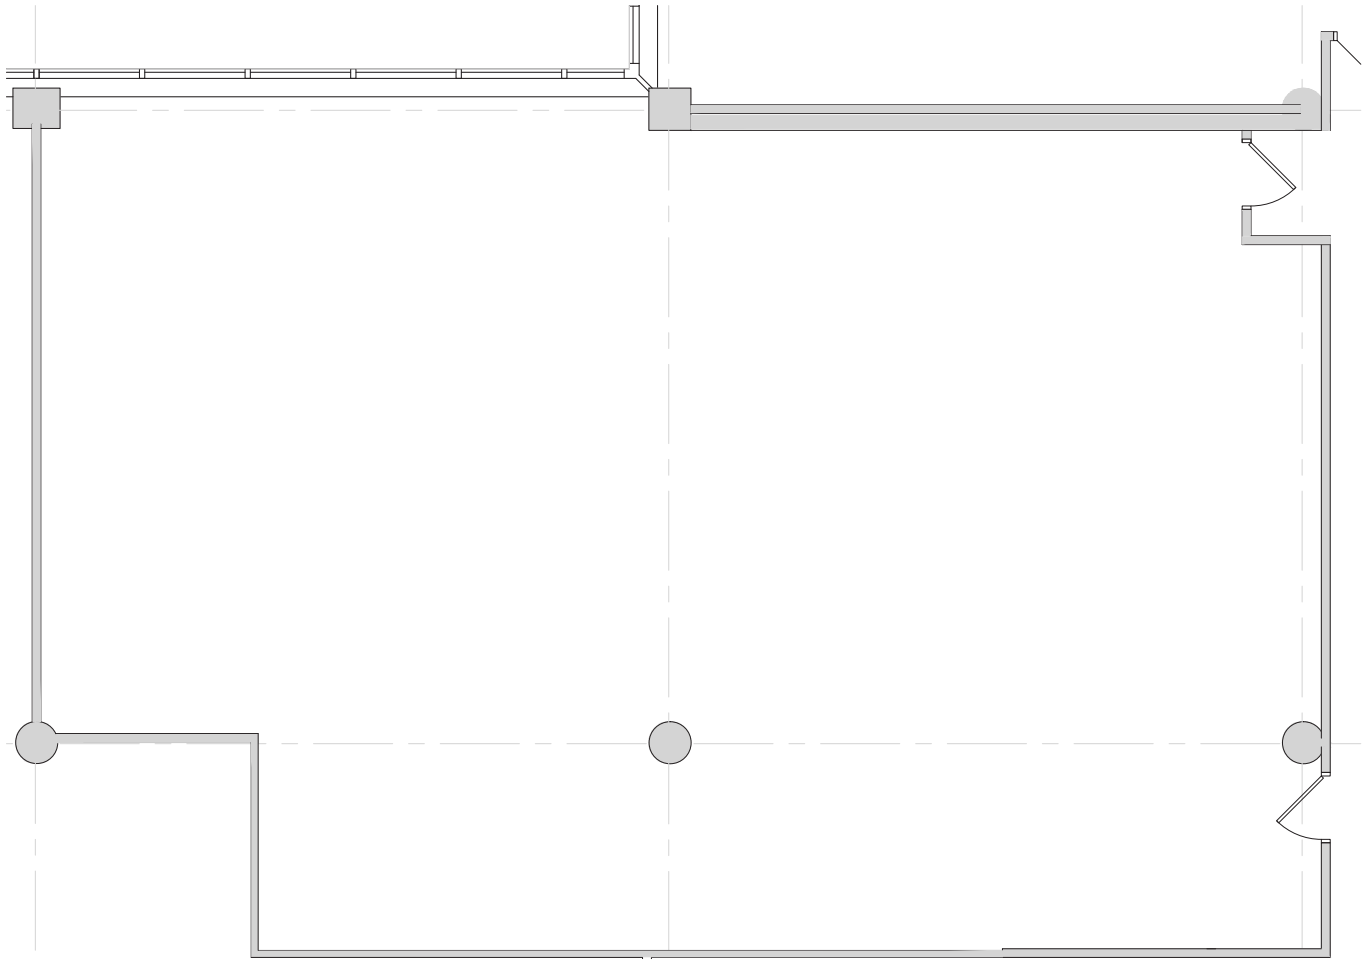

For further information, please contact our exclusive agents:

John Clark	Senior Managing Director	773.957.1410	jclark@ngkf.com
Rob Lundin	Senior Managing Director	773.957.1411	rlundin@ngkf.com
John Norris	Managing Director	773.957.1412	jnorris@ngkf.com