


GENERAL NOTES:

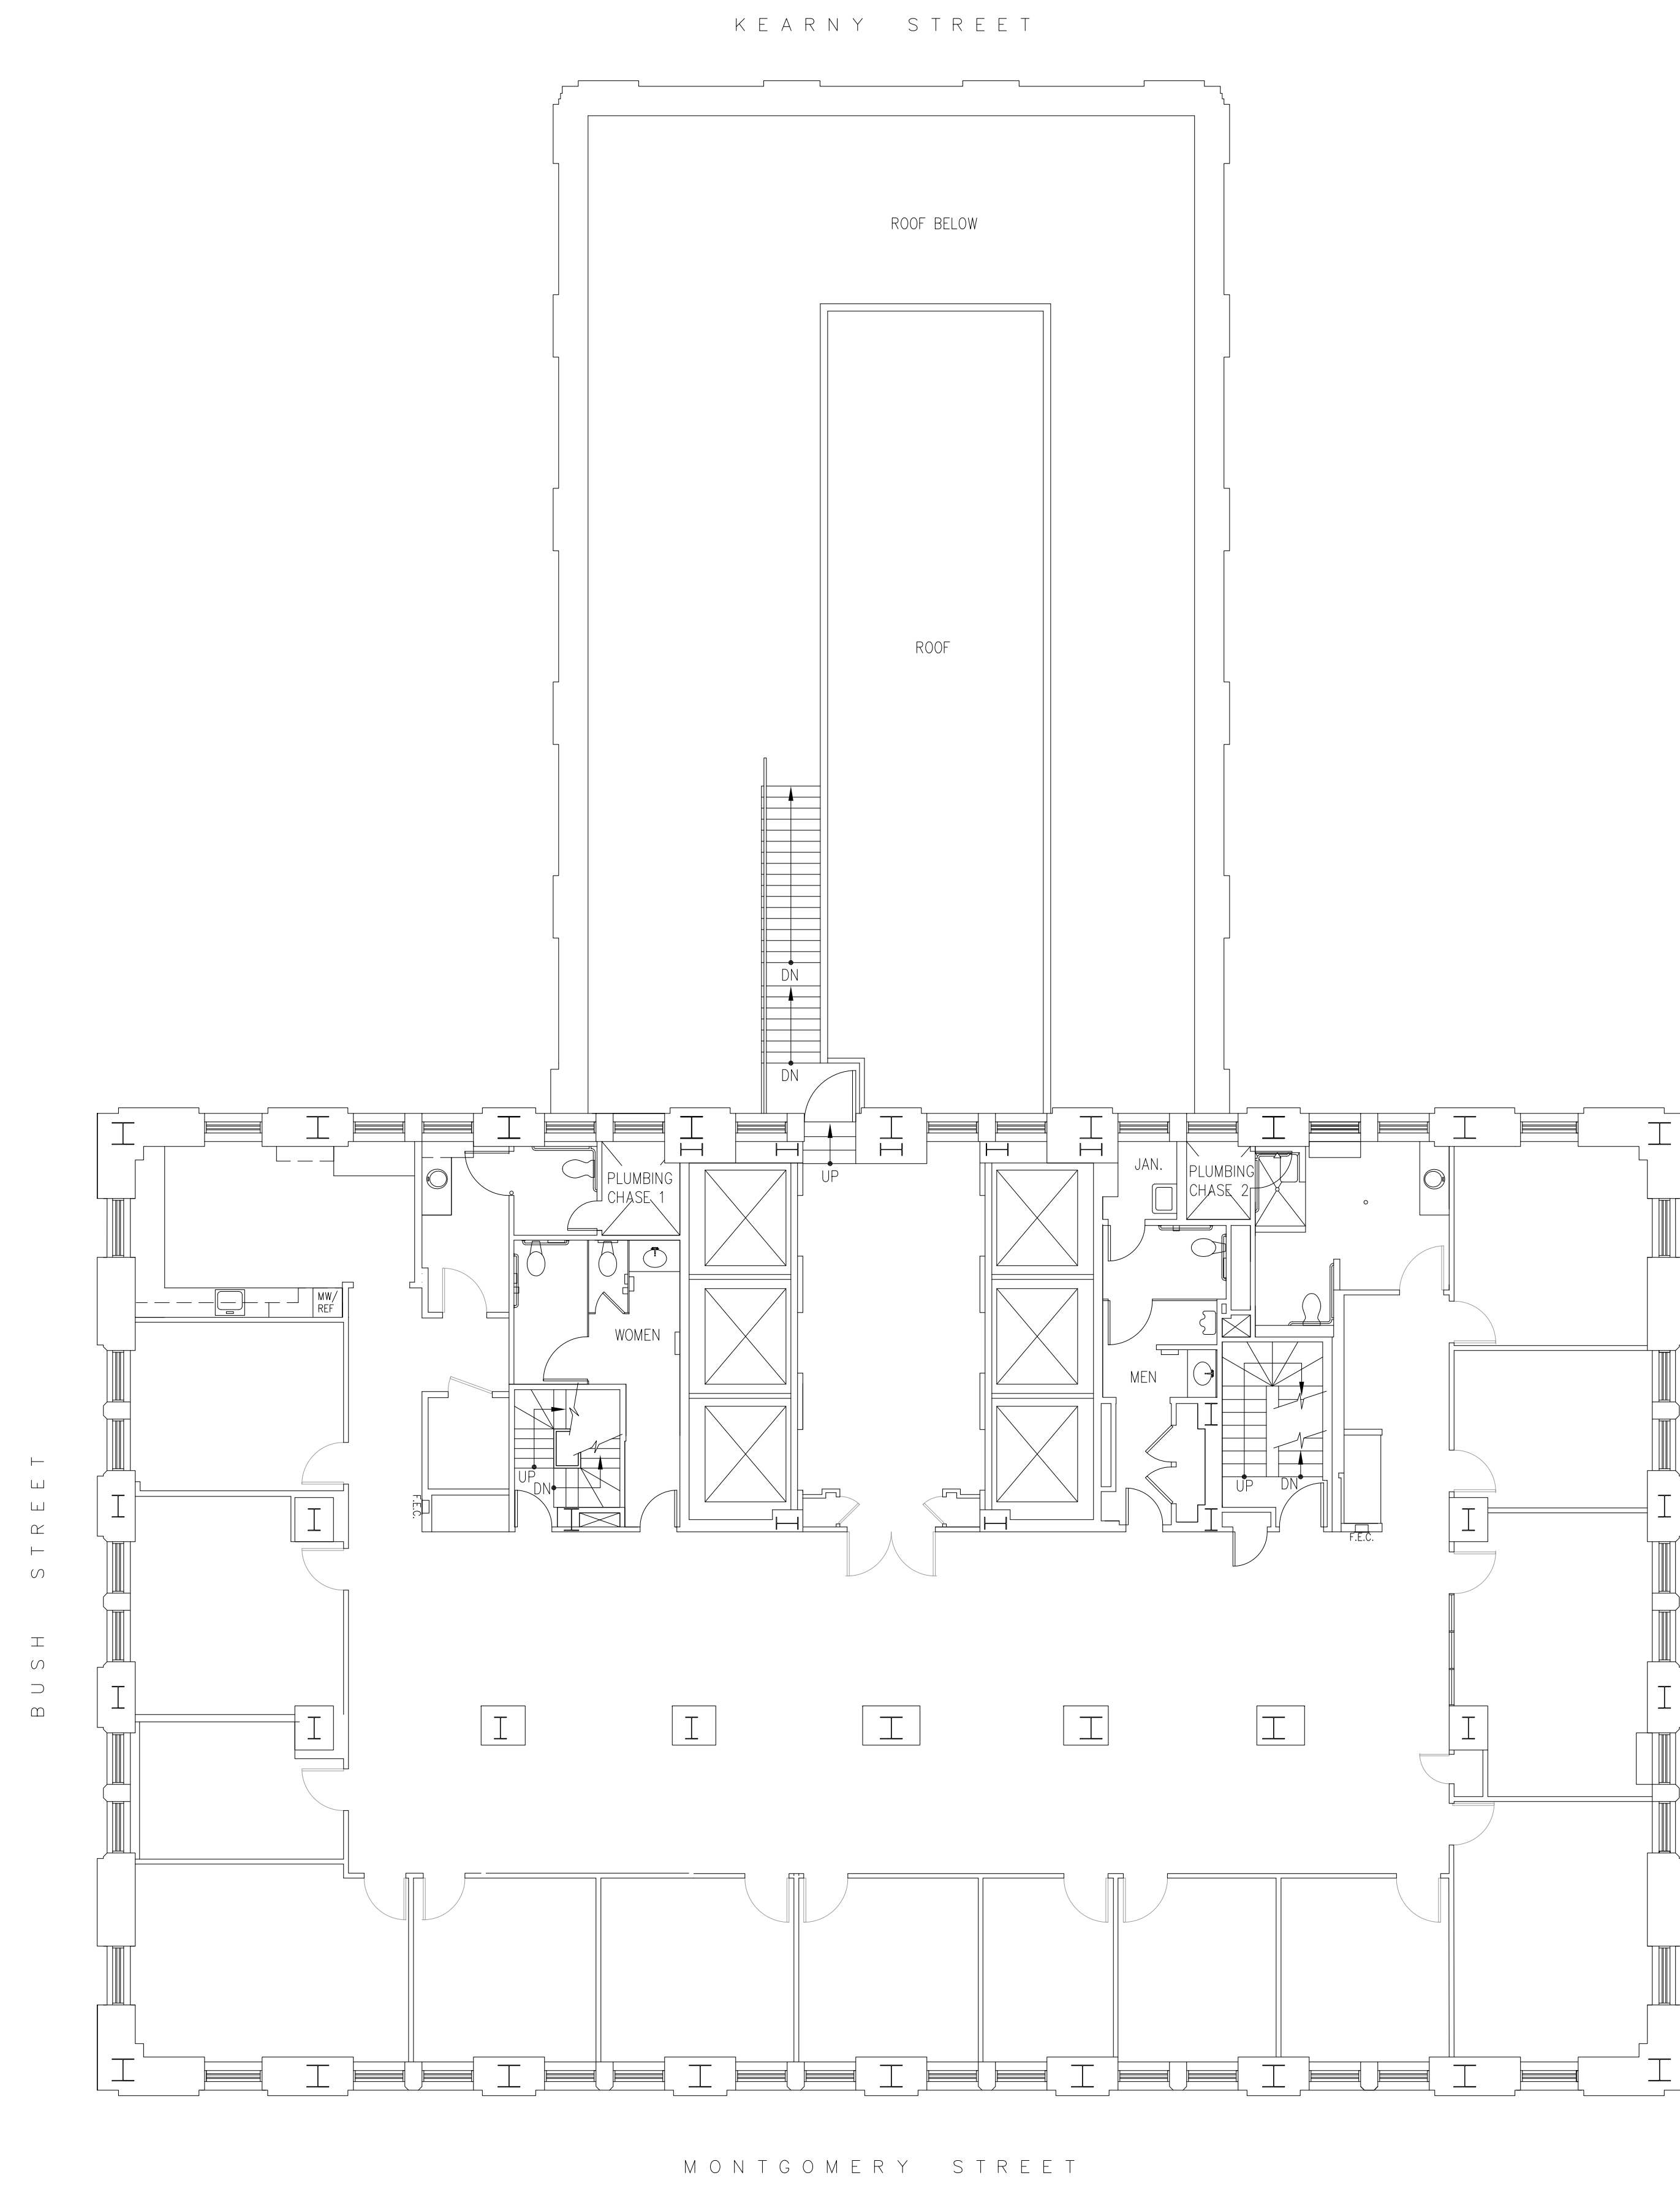

FIELD VERIFICATION OF ALL DIMENSIONS AND EXISTING CONDITIONS ARE THE RESPONSIBILITY OF ALL DESIGN AND/OR CONSTRUCTION PROFESSIONALS USING THESE DOCUMENTS. NO REPRESENTATION OF THE ACCURACY OF THESE DOCUMENTS IS PROVIDED.

SRS Archive	01/26/04
Restroom Retrofit Update	11/08/04
.	.
.	.
PROJECT NUMBER:
 BUILDING:
Russ Building
 235 Montgomery St.
 San Francisco, CA

Suite 2400

AS BUILT PLAN
 FILE NAME:
 I_24FBAB.dwg



PLOT PLAN
 CONSULTANT
 .
 .
 .

DRAWN BY: . SCALE: 1/8"=1'-0"