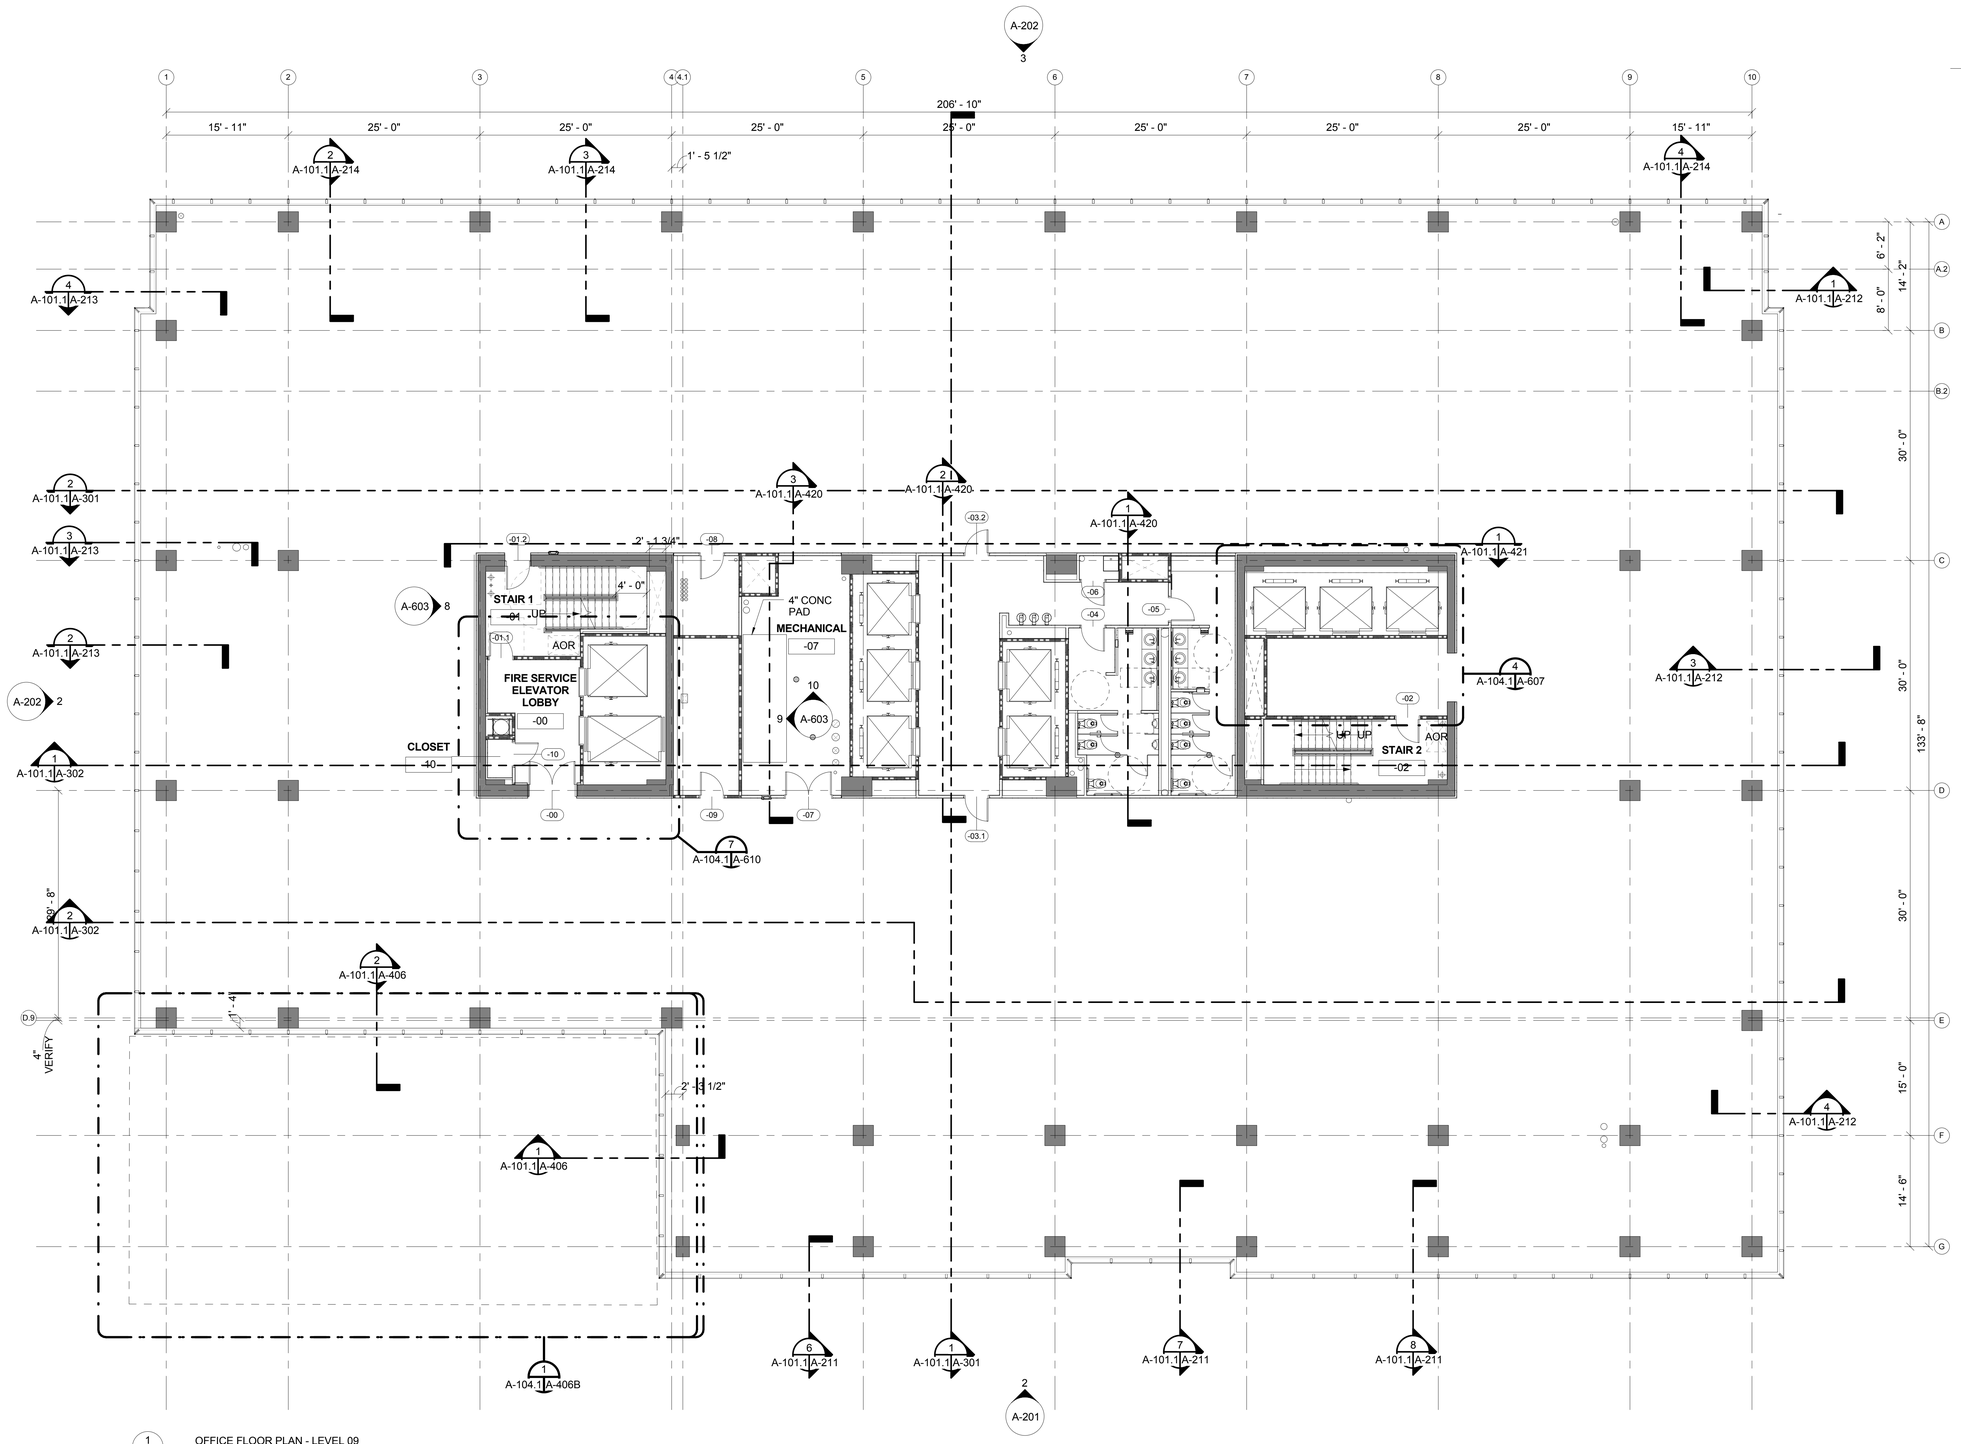

1 A-104.1 OFFICE FLOOR PLAN - LEVEL 09
1/8" = 1'-0"

KEYNOTES

MadisonMarquette

Mirecourt Associates, LLC

URS | AECOM
2020 K ST. NW, STE 300
WASHINGTON, DC 20006

SEALS

PROFESSIONAL CERTIFICATION. I CERTIFY THAT THESE DOCUMENTS WERE PREPARED OR APPROVED BY ME, AND THAT I AM A DULY LICENSED PROFESSIONAL ARCHITECT UNDER THE LAWS OF THE STATE OF MARYLAND, LICENSE NUMBER 18769, EXPIRATION DATE 10-05-2020.

One Light Street
Baltimore, Maryland

PROJECT ISSUE DATES

	DATE	DESCRIPTION
1	06/08/2018	BULLETIN #2 - CONFORMED SET
2	05/31/2019	RECORD DRAWINGS

DRAWN BY WDC | CHECKED BY DM | DESIGNER GB

URS PROJECT NO. 31945141

FLOOR PLAN - LEVEL 09 - OFFICE

A-104.1

0' 4' 8' 16' 32'

Copyright © 2009 URS Corporation, All Rights Reserved

6/4/2019 1:46:21 PM