
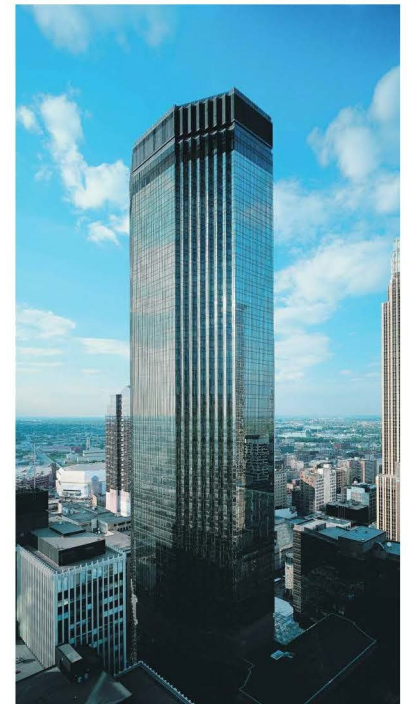


Twelfth Floor- As-Built Plan

9,363 Rentable Square Feet

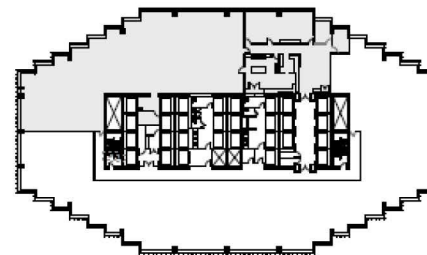

*THIS SUITE HAS NOT BEEN FIELD VERIFIED.

These listings are subject to error, omission, prior to lease or withdrawal without notice.