


*Handwritten signature*

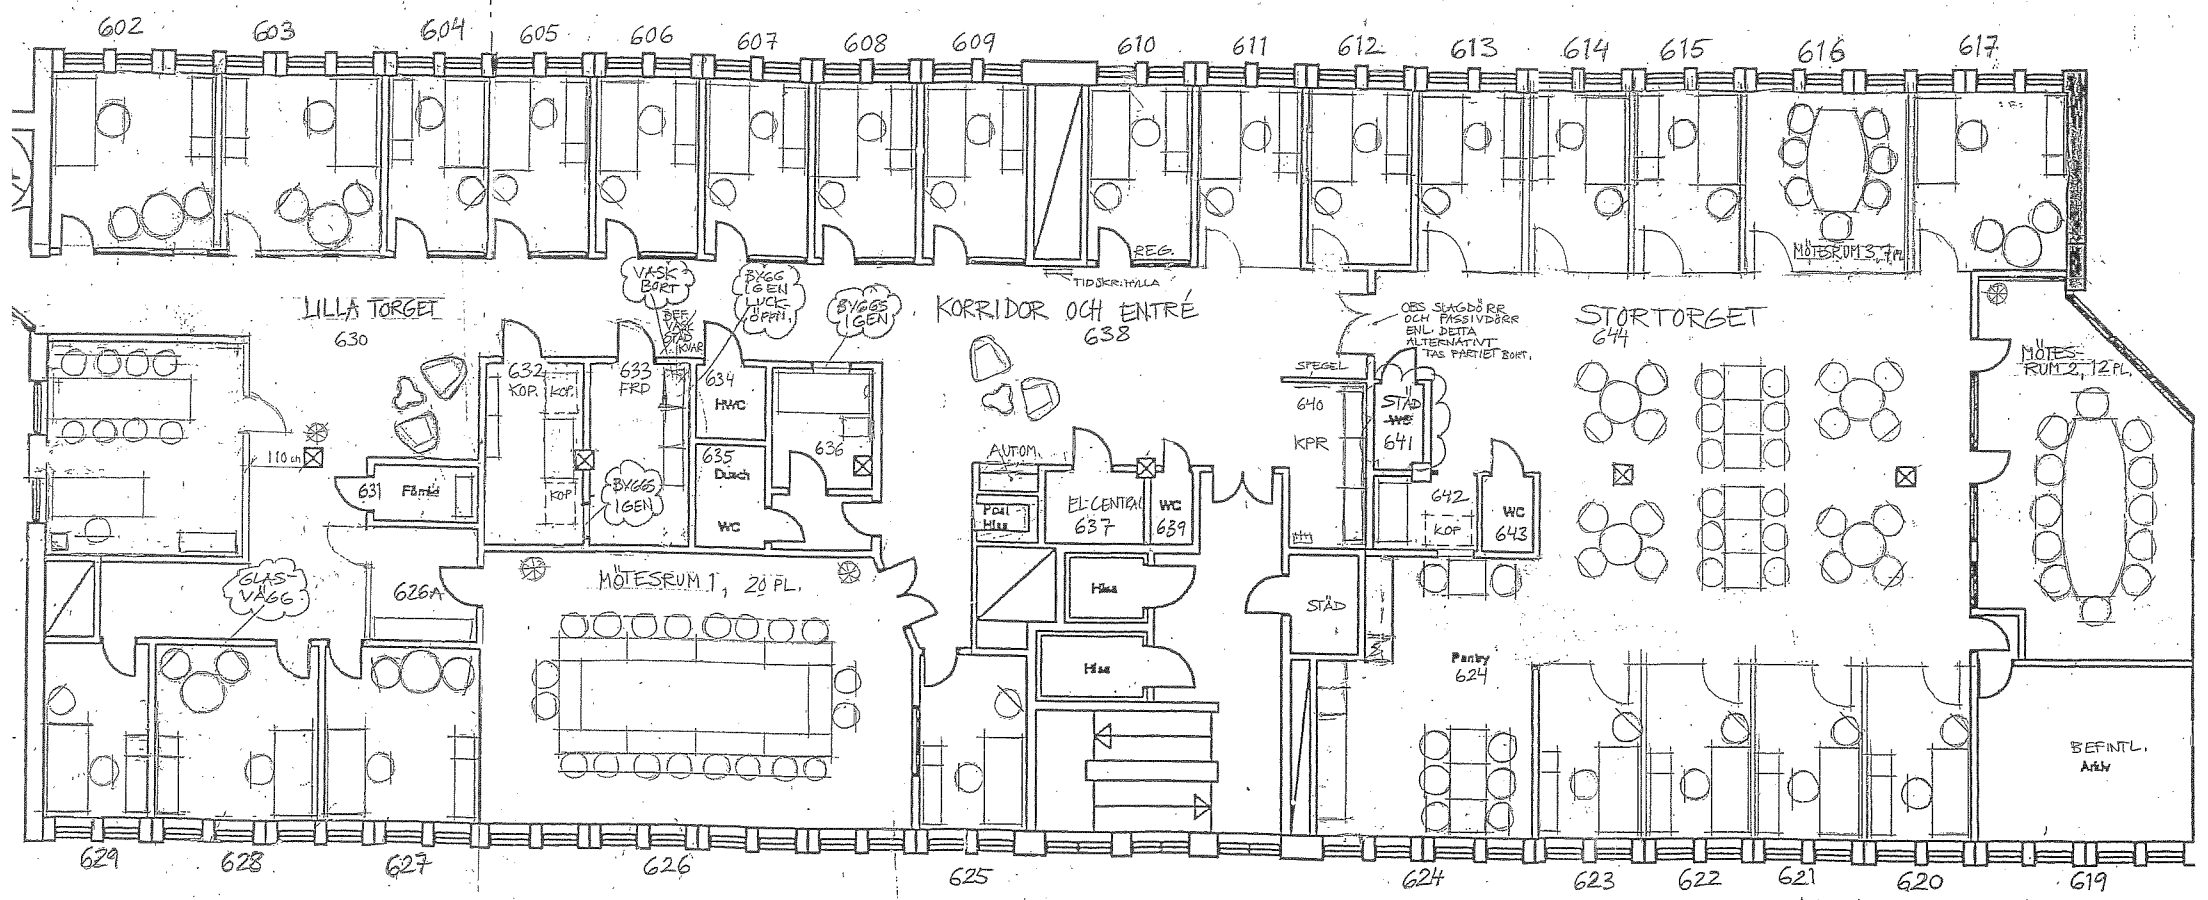

KV. KYLHuset, 15, HUS C, PLAN 6, 1  
INREDNING  
LOKALPLANERARNA 2011 04 18  
SKALA 1:1100 CA 14. 15 20

5 10 M