


Vån 3

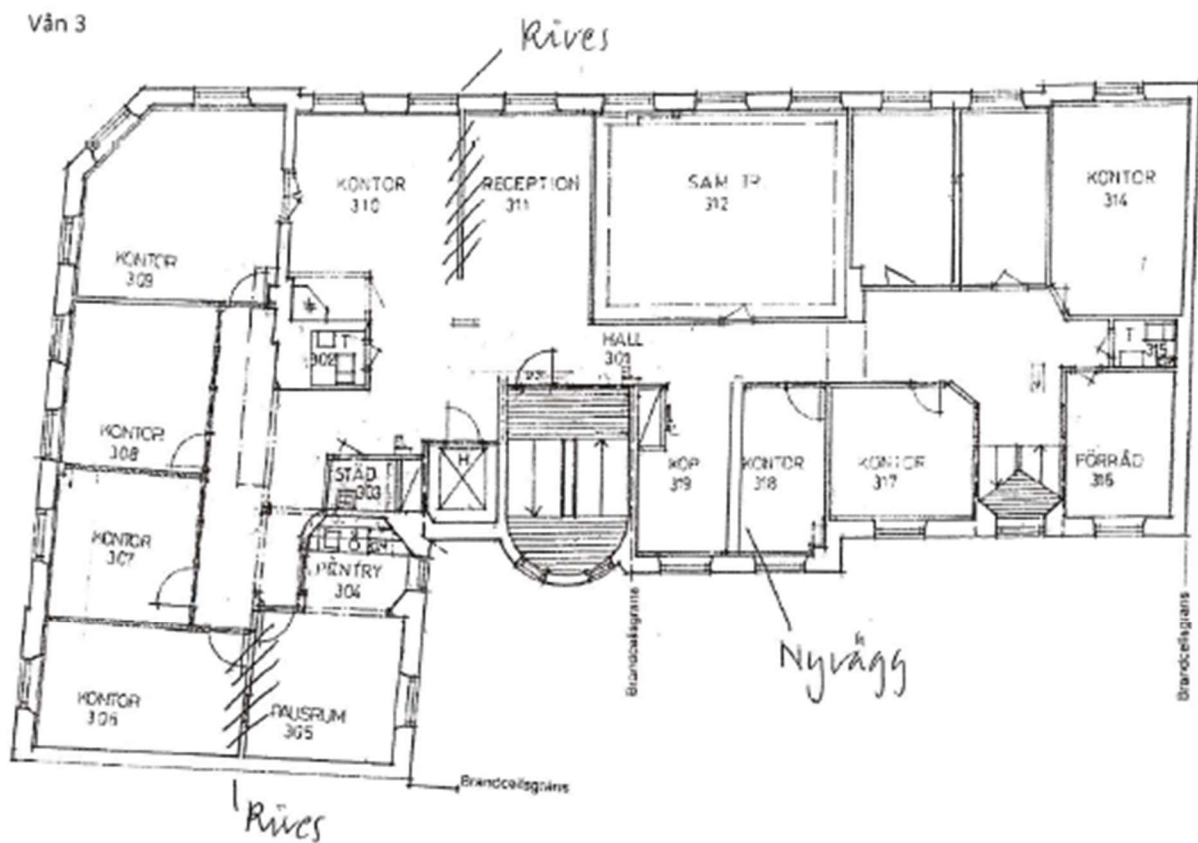

Vån 4

