

1st Floor – Suite 100 – 19,154 rsf As-Built Plan

901 Battery




www.901battery.com

Jim Collins
415.352.7239

jcollins@shorenstein.com
CA RE 00860991


Tom McDonnell
415.772.7086

tmcdonnell@shorenstein.com
CA RE 01011145

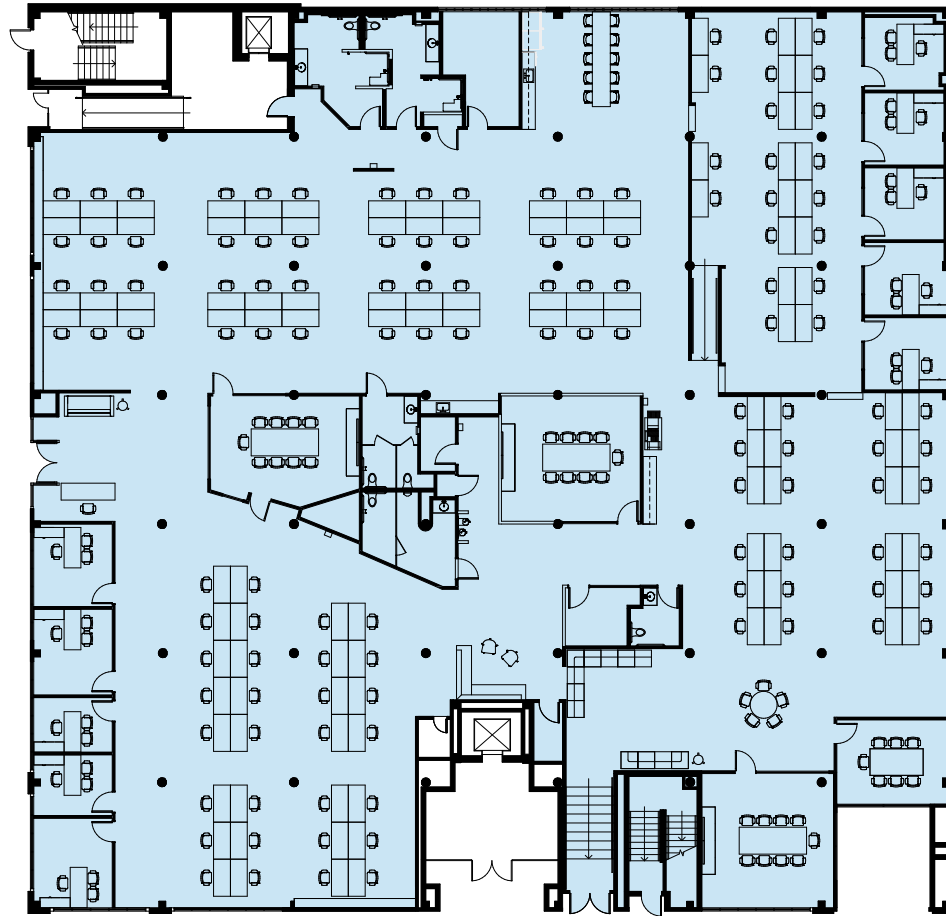

- 10 private offices
- 4 conference rooms
- Open area for 122 workstations
- Reception, collaborative lounge, break area, copy/IT room

This floor plan has been obtained from sources believed reliable, but has not been verified for accuracy or completeness. You should conduct a careful, independent investigation of the property and the floor plan, and verify all information prior to designing or building based on the information shown. Any reliance on this information is solely at your own risk.

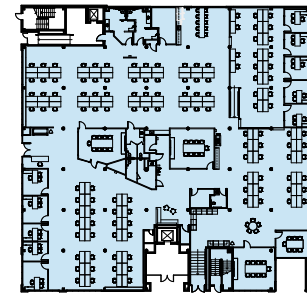

901 Battery St.
San Francisco, CA 94111