


SUITE 1150

11TH FLOOR | 6,375 RSF | AVAIL. NOW

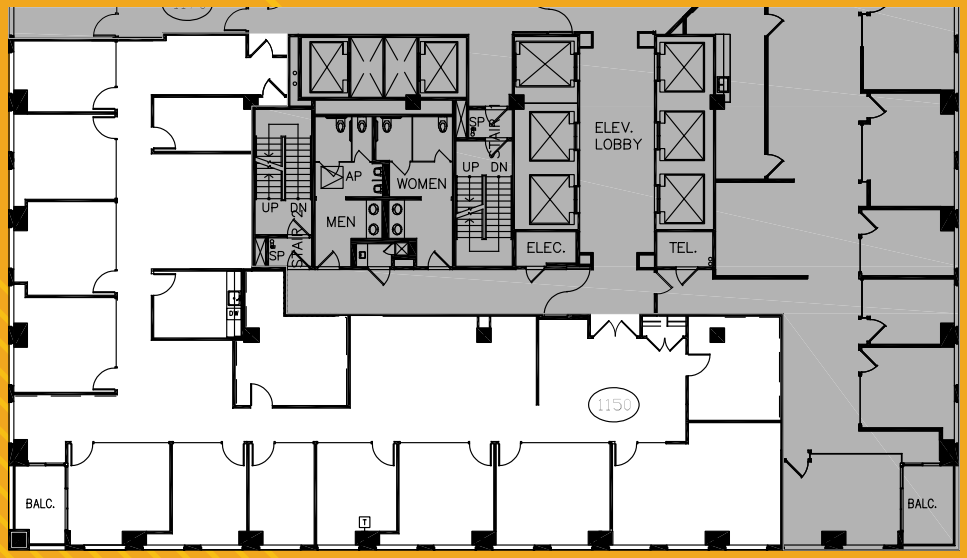

DOUBLE DOOR IDENTITY OFF THE ELEVATOR, 8 PRIVATE OFFICES, 3 BREAKOUT ROOMS, LARGE CONFERENCE ROOM, KITCHENETTE, STORAGE ROOM, SERVER ROOM, AND 1 PRIVATE DECK

VIRTUAL TOUR

*PLAN SHOWS AS-BUILT CONDITION

